

Pittsburgh Coal: Earl Percy, New Milton, Doddridge Co., W.Va.  
 Surface: Mr. Fay Barnett; R.F.D. #1, Blandville, Doddridge Co., W.Va.

New Location   
 Drill Deeper   
 Abandonment

Company The Tri-State Pipe Co.  
 Address Bellaire, Ohio.  
 Farm A.G. Percy  
 Tract Acres 29.1 Lease No. \_\_\_\_\_  
 Well (Farm) No. 1 Serial No. \_\_\_\_\_  
 Elevation (Spirit Level) Ground 1104.11  
 Quadrangle HOLBROOK  
 County Doddridge District New Milton  
 Engineer E.C. Tabler  
 Engineer's Registration No. \_\_\_\_\_  
 File No. \_\_\_\_\_ Drawing No. \_\_\_\_\_  
 Date Dec. 19<sup>th</sup> 1947 Scale 1" = 400 Feet

STATE OF WEST VIRGINIA  
 DEPARTMENT OF MINES  
 OIL AND GAS DIVISION  
 CHARLESTON

WELL LOCATION MAP  
 FILE NO. DCO-595-A

+ Denotes location of well on United States  
 Topographic Map, scale 1 to 62,500, lat-  
 itude and longitude lines being represented  
 by border lines as shown  
 - Denotes one inch spaces on border line  
 of original tracing.



503

STATE OF WEST VIRGINIA  
DEPARTMENT OF MINES  
OIL AND GAS DIVISION

WELL RECORD

Permit No. AD 595-A

Oil or Gas Well (X)  
(KING)


Company The Tri-State Pipe Company  
Address Bellaire, Ohio  
Farm A. G. Percy Acres 29.1  
Location (waters) Toms Fork  
Well No. 1 Elev. 1104.11  
District New Milton County Doddridge  
The surface of tract is owned in fee by Fay Barnett  
R. F. D. #1 Address Blandville, W. Va.  
Mineral rights are owned by Earl Percy  
Address New Milton, W. Va.

Casing and Tubing	Used in Drilling	Left in Well	Packers
Size			Kind of Packer
16			
13			
10	<b>387</b>	<b>None</b>	Size of
8 1/2	<b>1009</b>	<b>None</b>	
6	<b>1420</b>	<b>1420</b>	Depth set
5 3/16	<b>2075</b>	<b>2075</b>	
3			Perf. top
2	<b>2605</b>	<b>2605</b>	Perf. bottom
Liners Used			Perf. top
			Perf. bottom

Drilling commenced \_\_\_\_\_  
Drilling completed 8/11/22 1900  
Date Shot \_\_\_\_\_ From \_\_\_\_\_ To \_\_\_\_\_  
With \_\_\_\_\_  
Open Flow \_\_\_\_\_ /10ths Water in \_\_\_\_\_ Inch  
\_\_\_\_\_ /10ths Merc. in \_\_\_\_\_ Inch  
Volume \_\_\_\_\_ Cu. Ft.  
Rock Pressure \_\_\_\_\_ lbs. \_\_\_\_\_ hrs.  
Oil \_\_\_\_\_ bbls., 1st 24 hrs.  
Fresh water \_\_\_\_\_ feet \_\_\_\_\_ feet  
Salt water \_\_\_\_\_ feet \_\_\_\_\_ feet

CASING CEMENTED \_\_\_\_\_ SIZE \_\_\_\_\_ No. Ft. \_\_\_\_\_ Date \_\_\_\_\_  
COAL WAS ENCOUNTERED AT None FEET \_\_\_\_\_ INCHES  
\_\_\_\_\_ FEET \_\_\_\_\_ INCHES \_\_\_\_\_ FEET \_\_\_\_\_ INCHES  
\_\_\_\_\_ FEET \_\_\_\_\_ INCHES \_\_\_\_\_ FEET \_\_\_\_\_ INCHES

Formation	Color	Hard or Soft	Top	Bottom	Oil, Gas or Water	Depth Found	Remarks
Cow Run Sand			1100	1115			
Salt Sand			1272	1315			
Maxon Sand			1585	1650			
Big Lime			1810	1930			
Big Injun			1930	2010			
Stray Sand			2570	2583			
Slate			2583	2588			
Gordon Sand			2588	2593			
Oil			2588		Oil		
Total Depth				2605			

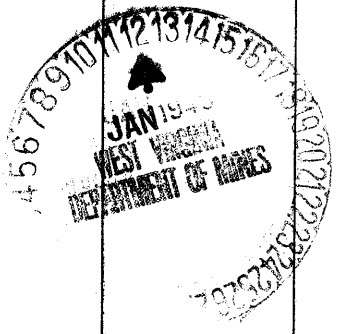



.....District, Doddridge County, W. Va.  
By South Penn Oil Co.  
"N.G.?"

70195

	Top.	Bottom.
First Sand	357	440
Cow Run Sand	1100	1115
Salt Sand	1275	1315
Maxton Sand	1585	1650
Big Lime	1810	1930
Big Injun Sand	1930	2010
Stray Sand	2570	2583
Slate	2583	2588
Gordon Sand (oil, 2589')	2588	2593
Total depth		2605