

New Location
 Drill Deeper
 Abandonment

Company E.S. Woodyard
 Address Petersboro, W. Va.
 Farm S.P. Ash
 Tract _____ Acres 124 3/4 Lease No. _____
 Well (Farm) No. 10 Serial No. _____
 Elevation (Spirit Level) 821
 Quadrangle Centerpoint
 County Doddridge District McCellan
 Engineer A.K. Westfall
 Engineer's Registration No. _____
 File No. _____ Drawing No. _____
 Date Jan. 9, 1948 Scale 1" = 40 Feet

STATE OF WEST VIRGINIA
 DEPARTMENT OF MINES
 OIL AND GAS DIVISION
 CHARLESTON

WELL LOCATION MAP
 FILE NO DOD-597A

+ Denotes location of well on United States Topographic Maps, scale 1 to 62,500, latitude and longitude lines being represented by border lines as shown
 - Denotes one inch spaces on border line of original tracing.



STATE OF WEST VIRGINIA
DEPARTMENT OF MINES
OIL AND GAS DIVISION

194

Permit No. 5911A

WELL RECORD

Oil or Gas Well Oil and gas
(KIND)


Company E.S. Woodyard
 Address Pennsboro, W. Va.
 Farm S.P. Ash Acres 124 7/8
 Location (waters) McElroy
 Well No. 10 Elev. 821
 District McClelland County Doddridge
 The surface of tract is owned in fee by S.P. Ash
 Address Shirley, W. Va.
 Mineral rights are owned by S.P. Ash
 Address Shirley, W. Va.

Drilling commenced _____
 Drilling completed Nov. 15, 1900
 Date Shot No record From _____ To _____
 With _____
 Open Flow /10ths Water in No record Inch
/10ths Merc. in No record Inch
 Volume No record Cu. Ft.
 Rock Pressure No record lbs. _____ hrs.
 Oil No record bbls., 1st 24 hrs.
 Fresh water No record feet _____ feet
 Salt water No record feet _____ feet

Casing and Tubing	Used in Drilling	Left in Well	Packers
Size			Kind of Packer
16			
13			
10	549	549	Size of
8 1/4	947		
6 5/8	1767	1767	Depth set
5 3/16			
3			Perf. top
2			Perf. bottom
Liners Used			Perf. top
			Perf. bottom

CASING CEMENTED _____ SIZE _____ No. Ft. _____ Date _____
 COAL WAS ENCOUNTERED AT _____ FEET _____ INCHES
 _____ FEET _____ INCHES FEET _____ INCHES
 _____ FEET _____ INCHES FEET _____ INCHES

Formation	Color	Hard or Soft	Top	Bottom	Oil, Gas or Water	Depth Found	Remarks
<u>Fitts. coal</u>			<u>454</u>				
<u>Big injun</u>			<u>1814</u>				
<u>Top pay</u>			<u>1914</u>				
<u>Total depth</u>				<u>1934</u>			

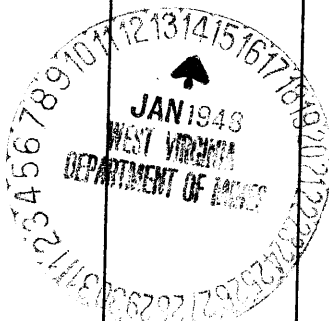

A-1 81948

