

There is no Commercial Coal.

Surface: Lloyd H. Collins; Greenwood Doddridge Co., W.Va.

New Location
 Drill Deeper
 Abandonment

Map N 26 S 12 W 15

Company The Tri-State Pipe Co.
 Address Bellaire, Ohio
 Farm Mary O'Donnell
 Tract Acres 83 1/2 Lease No. _____
 Well (Farm) No. 12445 Serial No. _____
 Elevation (Spirit Level) See above on Plat
 Quadrangle WEST UNION
 County Doddridge District Central
 Engineer E.C. Tabler
 Engineer's Registration No. _____
 File No. _____ Drawing No. _____
 Date Jan 21st 1948 Scale 1" = 400 Feet

STATE OF WEST VIRGINIA
 DEPARTMENT OF MINES
 OIL AND GAS DIVISION
 CHARLESTON

WELL LOCATION MAP

FILE NO. DOD-599-A-#1
DOD-600-A-#2
DOD-601-A-#4
DOD-602-A-#5

+ Denotes location of well on United States Topographic Maps, scale 1 to 62,500, latitude and longitude lines being represented by border lines as shown.

- Denotes one inch spaces on border line of original tracing.



500

STATE OF WEST VIRGINIA
DEPARTMENT OF MINES
OIL AND GAS DIVISION

WELL RECORD

Permit No. 6-1


Oil or Gas Well X (KIND)

Company The Tri-State Pipe Co.
 Address Bellaire, Ohio
 Farm Mary O'Donnell Acres 83 1/2
 Location (waters) _____
 Well No. 2 Elev. 924.54
 District Central County Doddridge
 The surface of tract is owned in fee by Lloyd H. Collins
 Address Greenwood, W. Va.
 Mineral rights are owned by No Commercial Coal.
 Address _____
 Drilling commenced _____
 Drilling completed March 1, 1918
 Date Shot _____ From _____ To _____
 With _____
 Open Flow _____ /10ths Water in _____ Inch
 _____ /10ths Merc. in _____ Inch
 Volume _____ Cu. Ft.
 Rock Pressure _____ lbs. _____ hrs.
 Oil _____ bbls., 1st 24 hrs.
 Fresh water _____ feet _____ feet
 Salt water _____ feet _____ feet

Casing and Tubing	Used in Drilling	Left in Well	Packers
Size			
16			Kind of Packer
13			
10			Size of
8 1/4	572'	572'	Depth set
6 5/8	1450'	1450'	
5 3/16	1840'	1840'	Perf. top
3			Perf. bottom
2	1921'	1921'	Perf. top
Liners Used			Perf. bottom

CASING CEMENTED 572 SIZE _____ No. Ft. _____
 COAL WAS ENCOUNTERED AT 576 FEET 36 INCHES
 _____ FEET _____ INCHES _____ FEET _____ INCHES
 _____ FEET _____ INCHES _____ FEET _____ INCHES

Formation	Color	Hard or Soft	Top	Bottom	Oil, Gas or Water	Depth Found	Remarks
Fresh Water			80		Water		
Water			485		Water		
Pittsburgh Coal			573	576			
Little Dunkard			960	980			
Big Dunkard			1050	1125			
1st. Salt			1320	1360			
2nd Salt			1370	1430			
Fresh Water			1390		Water		
Maxon			1735	1775			
Water			1770		Water		
Little Line			1780	1795			
Pencil Cave			1795	1798			
Big Lime			1798	1883			
Big Injun			1883				
Gas			1903	1909	Gas		
Oil			1903	1909	Oil		
Total Depth				1921			

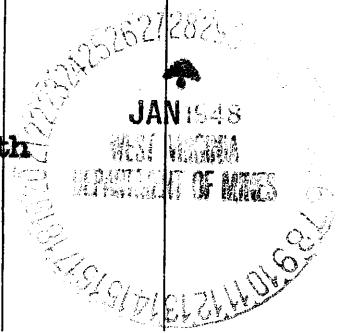

Formation	Color	Hard or Soft	Top	Bottom	Oil, Gas or Water	Depth Found	Remarks

Date Jan. 27, 1948

APPROVED The Tri-Pipe Co., Owner

By J. M. Rood, Contractor
(Title) sm

Central District, Doddridge County, W. Va.
 By The Tri-State Pipe Co., Bellairs, Ohio.
 On 8 1/2 acres.

Elevation, 924.54' l.

Surface owned by Lloyd N. Collins, Greenwood, W. Va.

Drilling completed March 1, 1918.

8 1/2" casing, 572'; 6 3/8", 1450'; 5 1/2", 1840'; 2" tubing, 1921'; all left in.

Coal was encountered at 573-576'.

Oil well. Abandonment reported to Dept. of Mines Jan. 27, 1948.

Record to ROT from Mrs. Griffith April 8, 1948. Old File No. 500.

	Top.	Bottom.
(fresh water, 80')		
(fresh water, 435')		
Pittsburgh Coal	573 -	576
Little Duckard Sand	960 -	980
Big Duckard Sand	1050 -	1125
1st Salt Sand	1320 -	1360
2nd Salt Sand (fresh water, 1390')	1370 -	1430
Horton Sand (water, 1770')	1735 -	1775
Little Mine	1780 -	1795
Pencil Cove	1795 -	1798
Big Mine	1798 -	1883
Big Injun Sand (gas, 1903-1909') (oil, 1903-1909')	1883 -
Total depth		1921