

Surface & Coal: H.C. Williams. Star Route.  
Tollgate, Doddridge Co. W. Va.

New Location  
Drill Deeper  
Abandonment X

On 800' map N 16

S1A-15 W1A-15

Company The Tri-State Pipe Co.  
 Address Bellaire Ohio  
 Farm H.B. Williams  
 Tract \_\_\_\_\_ Acres 2.01 Lease No. \_\_\_\_\_  
 Well (Farm) No. 3 Serial No. \_\_\_\_\_  
 Elevation (Spirit Level) Floor 1017.91  
 Ground 1014.91  
 Quadrangle HOLBROOK  
 County Doddridge District Central  
 Engineer E.C. Tabler  
 Engineer's Registration No. \_\_\_\_\_  
 File No. \_\_\_\_\_ Drawing No. \_\_\_\_\_  
 Date March 3<sup>d</sup> 1948 Scale 1" = 800 Feet

STATE OF WEST VIRGINIA  
DEPARTMENT OF MINES  
OIL AND GAS DIVISION  
CHARLESTON

WELL LOCATION MAP  
FILE NO. DOD-609-A

+ Denotes location of well on United States Topographic Maps, scale 1 to 62,500, latitude and longitude lines being represented by border lines as shown  
 - Denotes one inch spaces on border line of original tracing.



STATE OF WEST VIRGINIA  
DEPARTMENT OF MINES  
OIL AND GAS DIVISION

572

609-A

WELL RECORD

Permit No. \_\_\_\_\_

Oil or Gas Well \_\_\_\_\_ (KIND)

Company The Tri-State Pipe Co.  
Address Bellaire, Ohio  
Farm H. B. Williams Acres 201  
Location (waters) Cabin Run  
Well No. 3 Elev. 1014.91  
District Central County Doddridge  
The surface of tract is owned in fee by H. C. Williams  
Star Route - Address Tollgate, W. Va.  
Mineral rights are owned by Same as surface.  
Address \_\_\_\_\_


Drilling commenced \_\_\_\_\_  
Drilling completed 11/26/19  
Date Shot 12/8/19 From 2126 To 2132  
With \_\_\_\_\_  
Open Flow \_\_\_\_\_ /10ths Water in \_\_\_\_\_ Inch  
\_\_\_\_\_ /10ths Merc. in \_\_\_\_\_ Inch  
Volume \_\_\_\_\_ Cu. Ft.  
Rock Pressure \_\_\_\_\_ lbs. \_\_\_\_\_ hrs.  
Oil \_\_\_\_\_ bbls., 1st 24 hrs.  
Fresh water \_\_\_\_\_ feet \_\_\_\_\_ feet  
Salt water \_\_\_\_\_ feet \_\_\_\_\_ feet

| Casing and Tubing | Used in Drilling | Left in Well | Packers        |
|-------------------|------------------|--------------|----------------|
| Size              |                  |              | Kind of Packer |
| 16                |                  |              |                |
| 13                |                  |              |                |
| 10                | 501'             | 501'         | Size of        |
| 8 1/4             | 1246'            | 1246'        | Depth set      |
| 6 5/8             | 2077'            | 2077'        | Perf. top      |
| 5 3/16            |                  |              | Perf. bottom   |
| 3                 |                  |              | Perf. top      |
| 2                 | 2140'            | 2140'        | Perf. bottom   |
| Liners Used       |                  |              | Perf. top      |
|                   |                  |              | Perf. bottom   |

CASING CEMENTED \_\_\_\_\_ SIZE \_\_\_\_\_ No. Ft. \_\_\_\_\_ Date \_\_\_\_\_

COAL WAS ENCOUNTERED AT None FEET \_\_\_\_\_ INCHES  
\_\_\_\_\_ FEET \_\_\_\_\_ INCHES \_\_\_\_\_ FEET \_\_\_\_\_ INCHES  
\_\_\_\_\_ FEET \_\_\_\_\_ INCHES \_\_\_\_\_ FEET \_\_\_\_\_ INCHES

| Formation      | Color | Hard or Soft | Top  | Bottom | Oil, Gas or Water | Depth Found | Remarks |
|----------------|-------|--------------|------|--------|-------------------|-------------|---------|
| Little Dunkard |       |              | 1079 | 1115   |                   |             |         |
| Water          |       |              | 1153 |        |                   |             |         |
| Big Dunkard    |       |              | 1133 | 1163   |                   |             |         |
| Gas Sand       |       |              | 1270 | 1300   |                   |             |         |
| Maxon          |       |              | 1970 | 1994   |                   |             |         |
| Oil            |       |              | 1973 |        | Oil               |             |         |
| Big Lime       |       |              | 1994 | 2105   |                   |             |         |
| Big Injun      |       |              | 2105 | 2132   |                   |             |         |
| Oil            |       |              | 2127 | 2132   | Oil               |             |         |
| Gas            |       |              | 2116 |        | Gas               |             |         |
| Total Depth    |       |              |      | 2140   |                   |             |         |

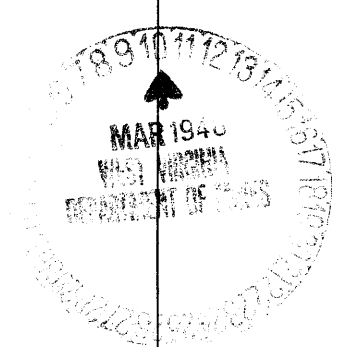



**AFFIDAVIT OF PLUGGING AND FILLING WELL**

AFFIDAVIT SHOULD BE MADE IN TRIPPLICATE AND COPY MADE BY THE OPERATOR AND ONE BY THE WELL OPERATOR AND THE OTHER COPY (AND OTHER COPIES IF REQUIRED) SHOULD BE MADE BY THE OPERATOR AND THE WELL OPERATOR AT THEIR RESPECTIVE ADDRESSES

**Mr. H. C. Williams**  
COAL OPERATOR OR OWNER  
**Star Route, Tollgate, W. Va.**  
ADDRESS

**THE TRI-STATE PIPE COMPANY**  
NAME OF WELL OPERATOR  
**WELLFIELE, OHIO**  
COMPLETE ADDRESS

**March 9** 19 **48**  
WELL AND LOCATION

**Central** District

**Dodridge** County

**Same as Coal**

**Well No. 3**

**H. B. Williams** Farm

**STATE INSPECTOR SUPERVISING PLUGGING** **Mr. D. E. Basist** was present.

**AFFIDAVIT**

**STATE OF WEST VIRGINIA,**  
 County of **Harrison** } DE:

**Harvey Goodwin** and **Coy Bathrie**  
 being first duly sworn according to law depose and say that they are experienced in the work of plugging and filling oil and gas wells and were employed by **The Tri-State Pipe Co.** well operator, and participated in the work of plugging and filling the above well, that said work was commenced on the **15th** day of **March**, 19**48**, and that the well was plugged and filled in the following manner:

| GRADE OR BENE SURFACE   | FILLING MATERIAL |      |                     | PIPING USED  | CASING      |             |
|-------------------------|------------------|------|---------------------|--|-------------|-------------|
|                         | CONTENT          | FEET | TO                  |  | ONE FEET IN | ONE FOOT IN |
|                         | Clay             | 2148 | 2087                | 2" Tub.  | 2140'       | None        |
|                         | Cement           | 2087 | 2077                | 6-5/8"   | 2082'       | 65'         |
|                         | Clay             | 2077 | 1950                |  |             |             |
|                         | Cement           | 1950 | 1940                |  |             |             |
| <b>Permanent bridge</b> |                  |      | 1330                |  |             |             |
|                         | Clay             | 1330 | 1256                |  |             |             |
|                         | Cement           | 1256 | 1246                | 8 1/2"   | 995'        | 251'        |
| <b>Permanent bridge</b> |                  |      | 683                 |  |             |             |
|                         | Clay             | 628  | to the surface, 10" |  | 501'        | None        |
|                         |                  |      |                     |  |             |             |
|                         |                  |      |                     |  |             |             |
|                         |                  |      |                     |  |             |             |
| <b>COAL BENE</b>        |                  |      |                     | <b>DESCRIPTION OF SEGMENT</b>  |             |             |
| <b>Zone Pittsburgh</b>  | Cement           | 683  | 628                 | Cement-size 33x13x10" thick with a cement post in center of 6-5/8" pipe, extended above cement base 5' with inscription THE TRI-STATE PIPE CO. March 1948. |             |             |
|                         |                  |      |                     |  |             |             |
|                         |                  |      |                     |  |             |             |

and that the work of plugging and filling said well was completed on the **24** th day of **March**, 19 **48**

And further deponents saith not.

Sworn to and subscribed before me this \_\_\_\_\_ day of \_\_\_\_\_ 1948.