

- Surface 1 • 6 Oberlin College; Mrs. Carrie B. Coffman; Shirley, W. Va.
- Surface 2 • Oberlin College; Jas. B. Smith Hrs. Address Mrs. Jas. B. Smith, Star Route, Smithfield, W. Va.
- Surface 3 • Oberlin College; B.R. Yeater, Star Route, Smithfield, W. Va.
- Pittsburgh Co. Mrs. Virginia Tetric, 271 Clay St. Clarksburg, W. Va.

New Location
 Drill Deeper
 Abandonment x

On 800' map N 48 S 3 W 2

Company Cassady and Mackey
 Address Star Route, West Union, W. Va.
 Farm Oberlin College
 Tract Acres Lease No. _____
 Well (Farm) No. 1 2 5 6 Serial No. _____
 Elevation (Spirit Level) See above at Wells.
 Quadrangle CENTERPOINT
 County McClellan District Doddridge
 Engineer E.C. Tabler
 Engineer's Registration No. _____
 File No. _____ Drawing No. _____
 Date March 1st 1948 Scale 1" = 800 Feet

STATE OF WEST VIRGINIA
 DEPARTMENT OF MINES
 OIL AND GAS DIVISION
 CHARLESTON

WELL LOCATION MAP
 DOD-624-A-#1
 FILE NO. DOD-625-A-#2
 DOD-626-A-#5
 DOD-627-A-#6

+ Denotes location of well on United States Topographic Maps, scale 1 to 62,500, latitude and longitude lines being represented by border lines as shown.
 - Denotes one inch spaces on border line of original tracing.



STATE OF WEST VIRGINIA
DEPARTMENT OF MINES
OIL AND GAS DIVISION

565

Ad 64-A

WELL RECORD

Permit No. _____

Oil or Gas Well _____ (KIND)


Company Leroy Cassidy
Address West Union, W. Va. Star Rt.
Farm OSBERLIN COLLEGE Acres 38-1/2
Location (waters) Franks Run
Well No. 1 Elev 1164.40
District McClellan County Doddridge
The surface of tract is owned in fee by _____
Address _____
Mineral rights are owned by _____
Address _____

Casing and Tubing	Used in Drilling	Left in Well	Packers
Size			Kind of Packer
16			
13	18	18	
10	640	640	Size of
8 1/4	1450	1450	
6 5/8	2173	2173	Depth set
5 3/16			
3			Perf. top
2			Perf. bottom
Liners Used			Perf. top
			Perf. bottom

Drilling commenced _____
Drilling completed _____
Date Shot 12-16-96 From 2300 To 2320
With 20 Qts
Open Flow /10ths Water in _____ Inch
/10ths Merc. in _____ Inch
Volume _____ Cu. Ft.
Rock Pressure _____ lbs. _____ hrs.
Oil _____ bbls., 1st 24 hrs.
Fresh water _____ feet _____ feet
Salt water _____ feet _____ feet

CASING CEMENTED _____ SIZE _____ No. Ft. _____ Date _____
COAL WAS ENCOUNTERED AT 845 FEET _____ INCHES
_____ FEET _____ INCHES FEET _____ INCHES
_____ FEET _____ INCHES FEET _____ INCHES

Formation	Color	Hard or Soft	Top	Bottom	Oil, Gas or Water	Depth Found	Remarks
Pittsbg, Coal			1	845			
Big Injun Sand				2229	2300		
OXIX Total Depth				2327			

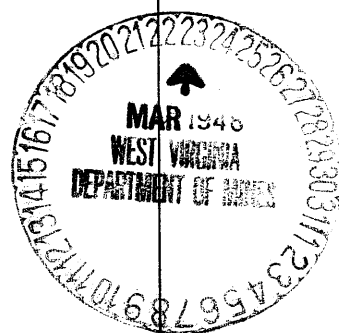

(C)