


Latitude 34 25
39 25

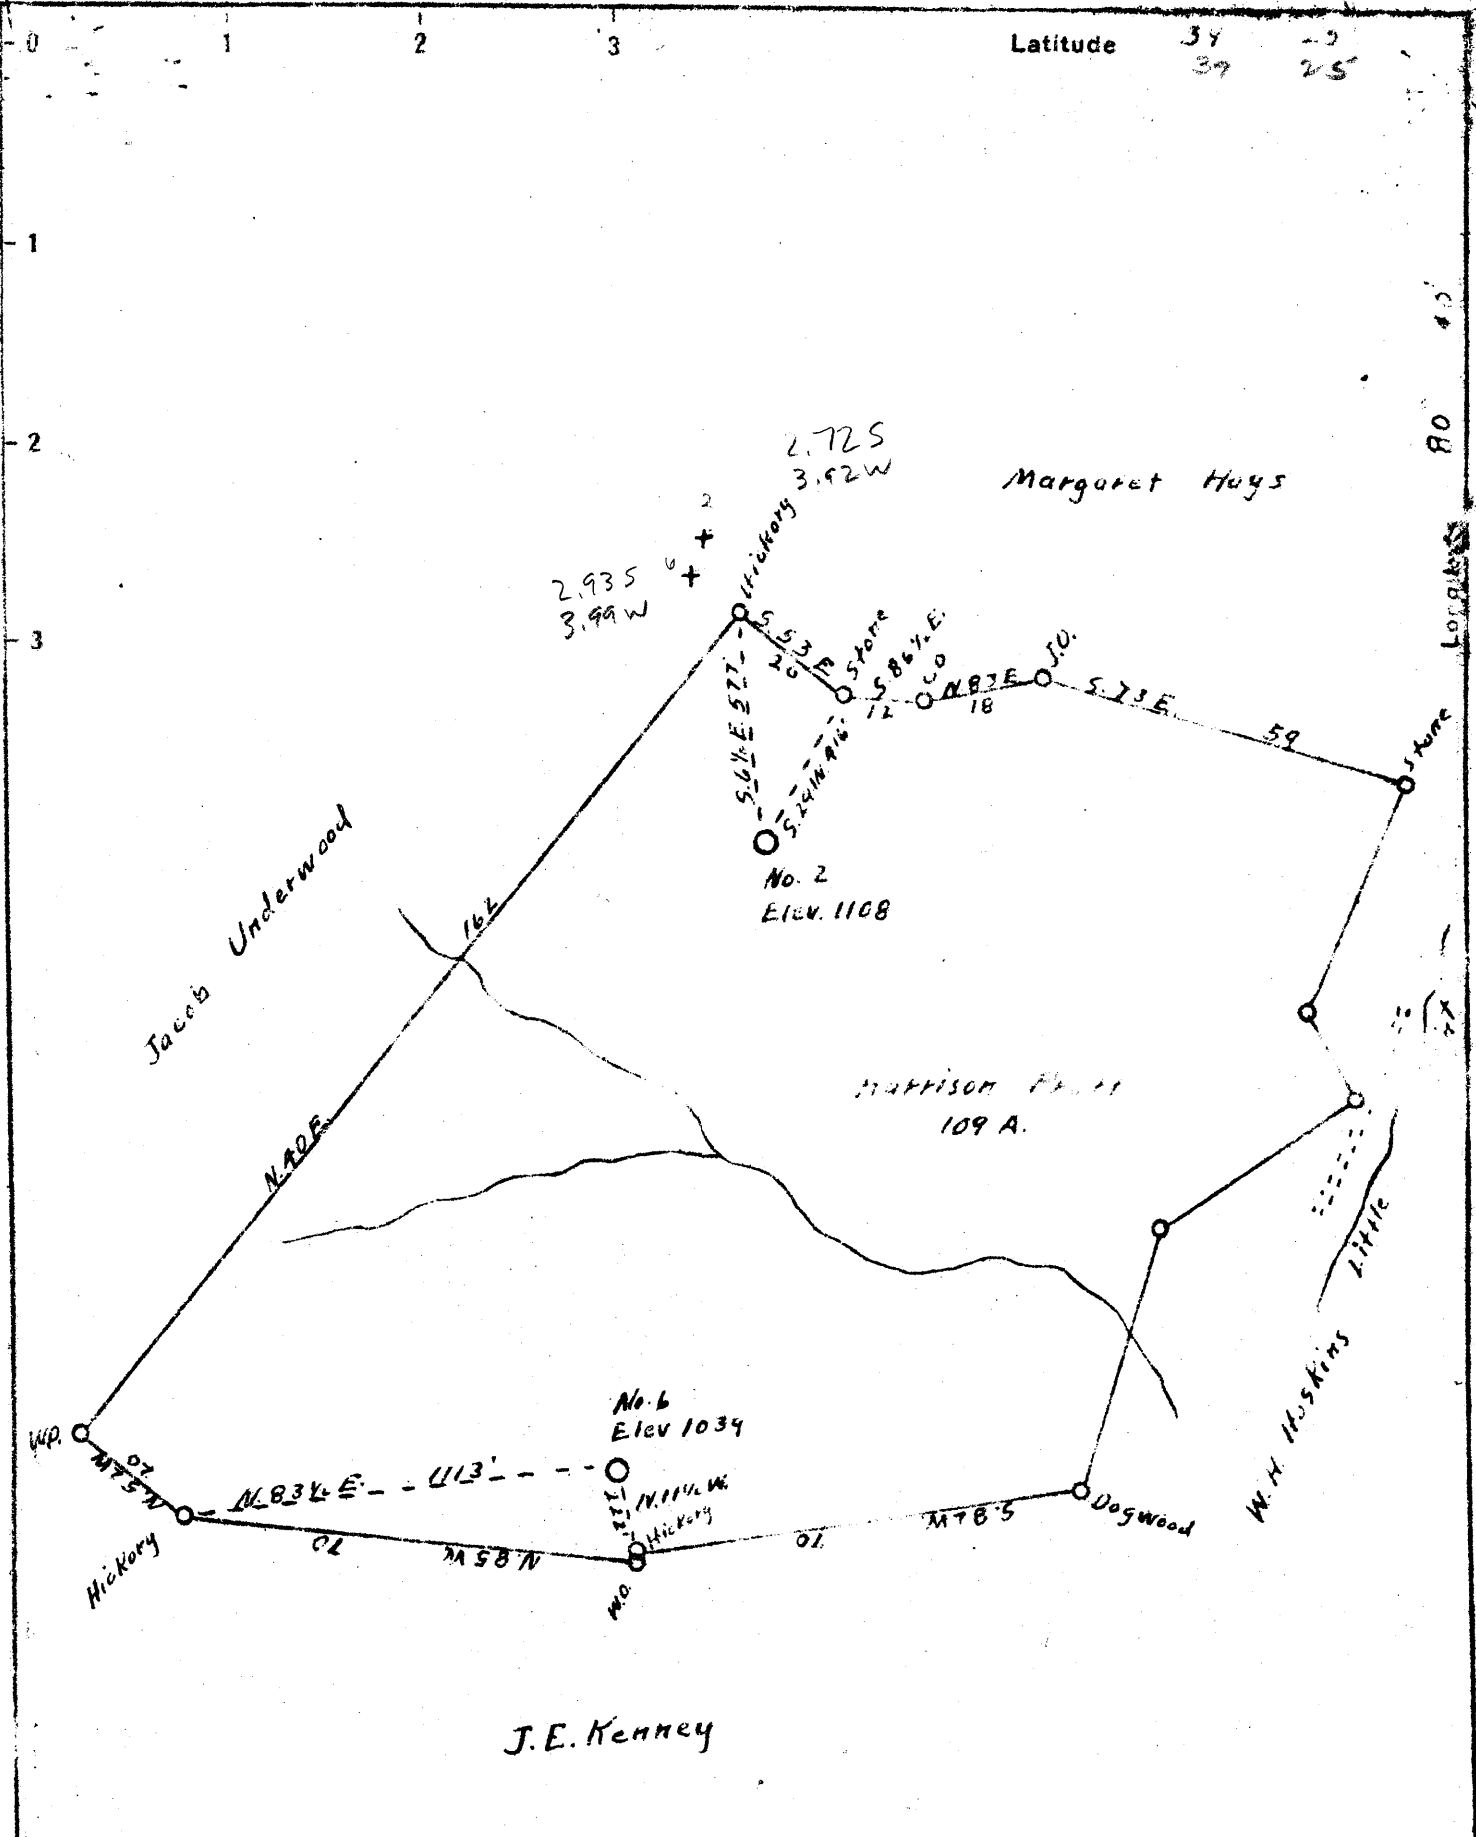

New Location
 Drill Deeper
 Abandonment

Company E.S. Woodyard
 Address Pennsboro W.Va.
 Farm Harrison Pratt
 Tract _____ Acres 109 Lease No. _____
 Well (Farm) No. 2-6 Serial No. _____
 Elevation (Spirit Level) 1108 - 1039
 Quadrangle Centerpoint
 County Doddridge District Grant
 Engineer A. K. Westfall
 City and State's Registration No. _____
 Drawing No. _____
 Date 4-14-48 Scale 1" = 30' poles

STATE OF WEST VIRGINIA
 DEPARTMENT OF MINES
 OIL AND GAS DIVISION
 CHARLESTON

WELL LOCATION MAP

FILE NO. DOD-641-A-#2
DOD-642-A-#6

+ Denotes location of well on United States Topographic Maps, scale 1 to 62,500, latitude and longitude lines being represented by border lines as shown.
 - Denotes one inch spaces on border line of original tracing

39° 25'

LATITUDE

LONGITUDE

39° 25'

2.595
2.885

30641

1.78 W

30642

1.83 miles

30641 30642
7.5 loc 2.595 2.885

7.5 OGIS topo location

1.78 W 1.83 W 7.5' loc _____ 15' loc _____
(calc.) _____

Company _____

Farm Harrison Pratt 2 & 6

Quad Centerpoint

County Doddridge

District _____

WELL LOCATION MAP

File No. 30641-30642

Doddridge



528

STATE OF WEST VIRGINIA
DEPARTMENT OF MINES
OIL AND GAS DIVISION

WELL RECORD

Permit No. 642A

Oil or Gas Well Oil

Company E.S. Woodyard
 Address Pennsboro, W. Va.
 Farm Harrison Pratt Acres 109
 Location (waters) Little Flint
 Well No. 6 Elev. 1039
 District Grant County Doddridge
 The surface of tract is owned in fee by Harrison Pratt
 Address Shirley, W. Va.
 Mineral rights are owned by Harrison Pratt
 Address Shirley, ...
 Drilling commenced Unknown
 Drilling completed Unknown
 Date Shot Unknown From To
 With
 Open Flow /10ths Water in Inch
 /10ths Merc. in Inch
 Volume Cu. Ft.
 Rock Pressure lbs. hrs.
 Oil Unknown bbls., 1st 24 hrs.
 Fresh water feet feet
 Salt water feet feet

Casing and Tubing	Used in Drilling	Left in Well	Packers
Size			
16			Kind of Packer
13			
10			Size of
8 1/4	1143'		
6 3/4	2008'	2008'	Depth set
5 3/16	785'	785'	
3			Perf. top
2	2140'	2140'	Perf. bottom
Liners Used			Perf. top
			Perf. bottom

CASING CEMENTED SIZE No. Ft. Date
 COAL WAS ENCOUNTERED AT None FEET INCHES
 FEET INCHES FEET INCHES
 FEET INCHES FEET INCHES

Formation	Color	Hard or Soft	Top	Bottom	Oil, Gas or Water	Depth Found	Remarks
Pitts. coal			None				
Big Injun			2054'				
1st pay			2060'				
2nd pay			2137'				
Total depth				2144'			

