


Latitude 39 25

0.125
2.40W

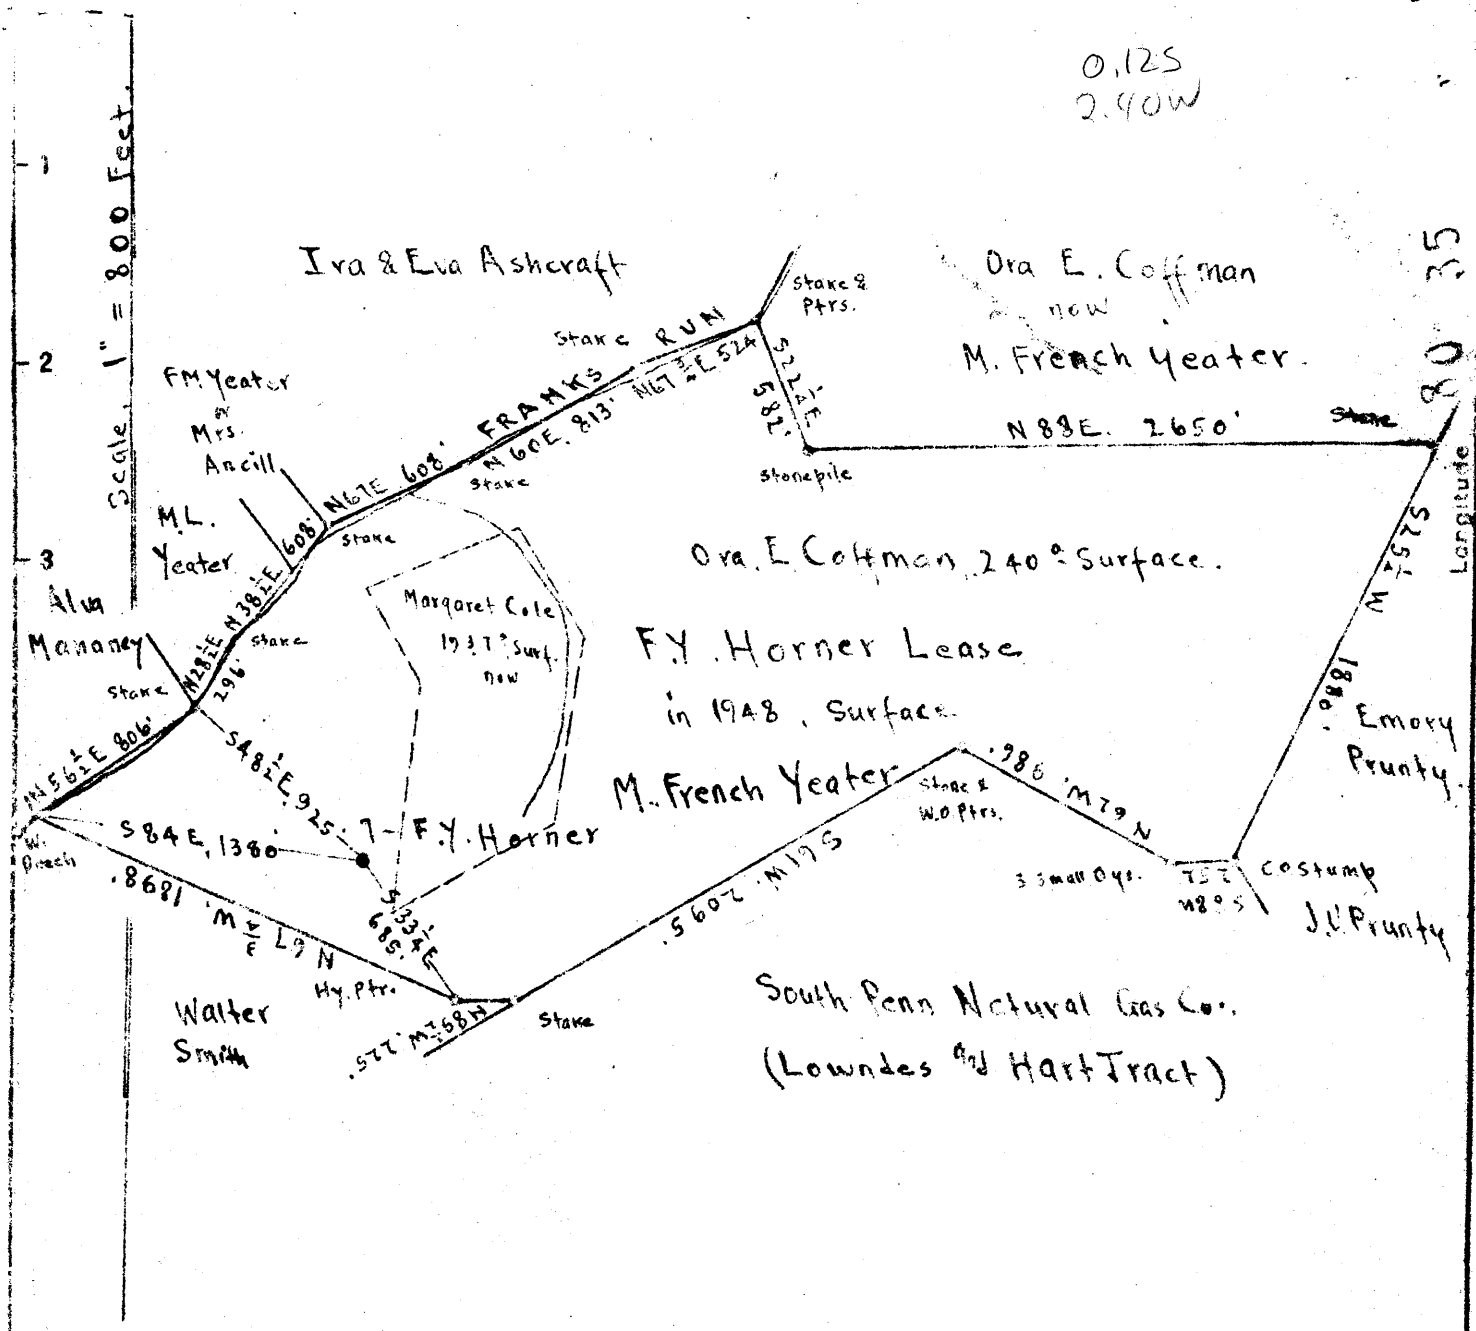

Surface: M. French Yeater, Star Route, Smithfield, W.Va.
 Pittsburgh Coal: State of West Virginia.

New Location
 Drill Deeper
 Abandonment

On 800' map N 48. S 3 E 1 W 1

Company Cassady and Mackey
 Address Star Route, West Union, W.Va.
 Farm F.Y. Horner
 Tract Acres 240 Lease No. _____
 Well (Farm) No. 7 Serial No. _____
 Elevation (Spirit Level) Floor - 1237.70
Ground - 1236.00
 Quadrangle CENTERPOINT
 County Doddridge District McClellan
 Engineer E.C. Tabler
 Engineer's Registration No. _____
 File No. _____ Drawing No. _____
 Date March 18th 1948 Scale 1" = 800 Feet

STATE OF WEST VIRGINIA
 DEPARTMENT OF MINES
 OIL AND GAS DIVISION
 CHARLESTON

WELL LOCATION MAP
 FILE NO. DOD-650-A

+ Denotes location of well on United States Topographic Maps, scale 1 to 62,500, latitude and longitude lines being represented by border lines as shown.
 - Denotes one inch spaces on border line of original tracing



524

STATE OF WEST VIRGINIA
DEPARTMENT OF MINES
OIL AND GAS DIVISION

WELL RECORD

Oil or Gas Well Oil
(KIND)

Permit No. AD 150 A

Company Leroy Cassady
Address West Union W. Va. Star Rt.
Farm F. Y. Horner Acres 240
Location (waters) Franks Run
Well No. 7 Elev. 1236
District McClellan County Doddridge
The surface of tract is owned in fee by M. French Yeater
Smithfield W. Va. Address Star Rt.
Mineral rights are owned by State of W. Va.
Address _____

Drilling commenced _____
Drilling completed _____
Date Shot 12-22-03 From 2387 To _____
With _____
Open Flow _____ /10ths Water in _____ Inch
_____ /10ths Merc. in _____ Inch
Volume _____ Cu. Ft.
Rock Pressure _____ lbs. _____ hrs.
Oil _____ bbls., 1st 24 hrs.
Fresh water _____ feet _____ feet
Salt water _____ feet _____ feet

Casing and Tubing	Used in Drilling	Left in Well	Packers
Size			Kind of Packer
16			
13			
10			Size of
8 1/4	1466	1466	
6 3/4	2234	2234	Depth set
5 3/16	2258	2258	
3			Perf. top
2			Perf. bottom
Liners Used			Perf. top
			Perf. bottom

CASING CEMENTED _____ SIZE _____ No. Ft. _____ Date _____

COAL WAS ENCOUNTERED AT 945 FEET _____ INCHES
_____ FEET _____ INCHES _____ FEET _____ INCHES
_____ FEET _____ INCHES _____ FEET _____ INCHES

Formation	Color	Hard or Soft	Top	Bottom	Oil, Gas or Water	Depth Found	Remarks
Pittsburgh	Coal		945				
Dunkard			1460	1505			
Salt Sand			1836	1986			
Big Lime			2210	2285	Oil	2384 2390	
Big Injun			2286	2393	Water	2393	
Total Depth							2408

