


Latitude 39° 15'

Longitude 80° 30'

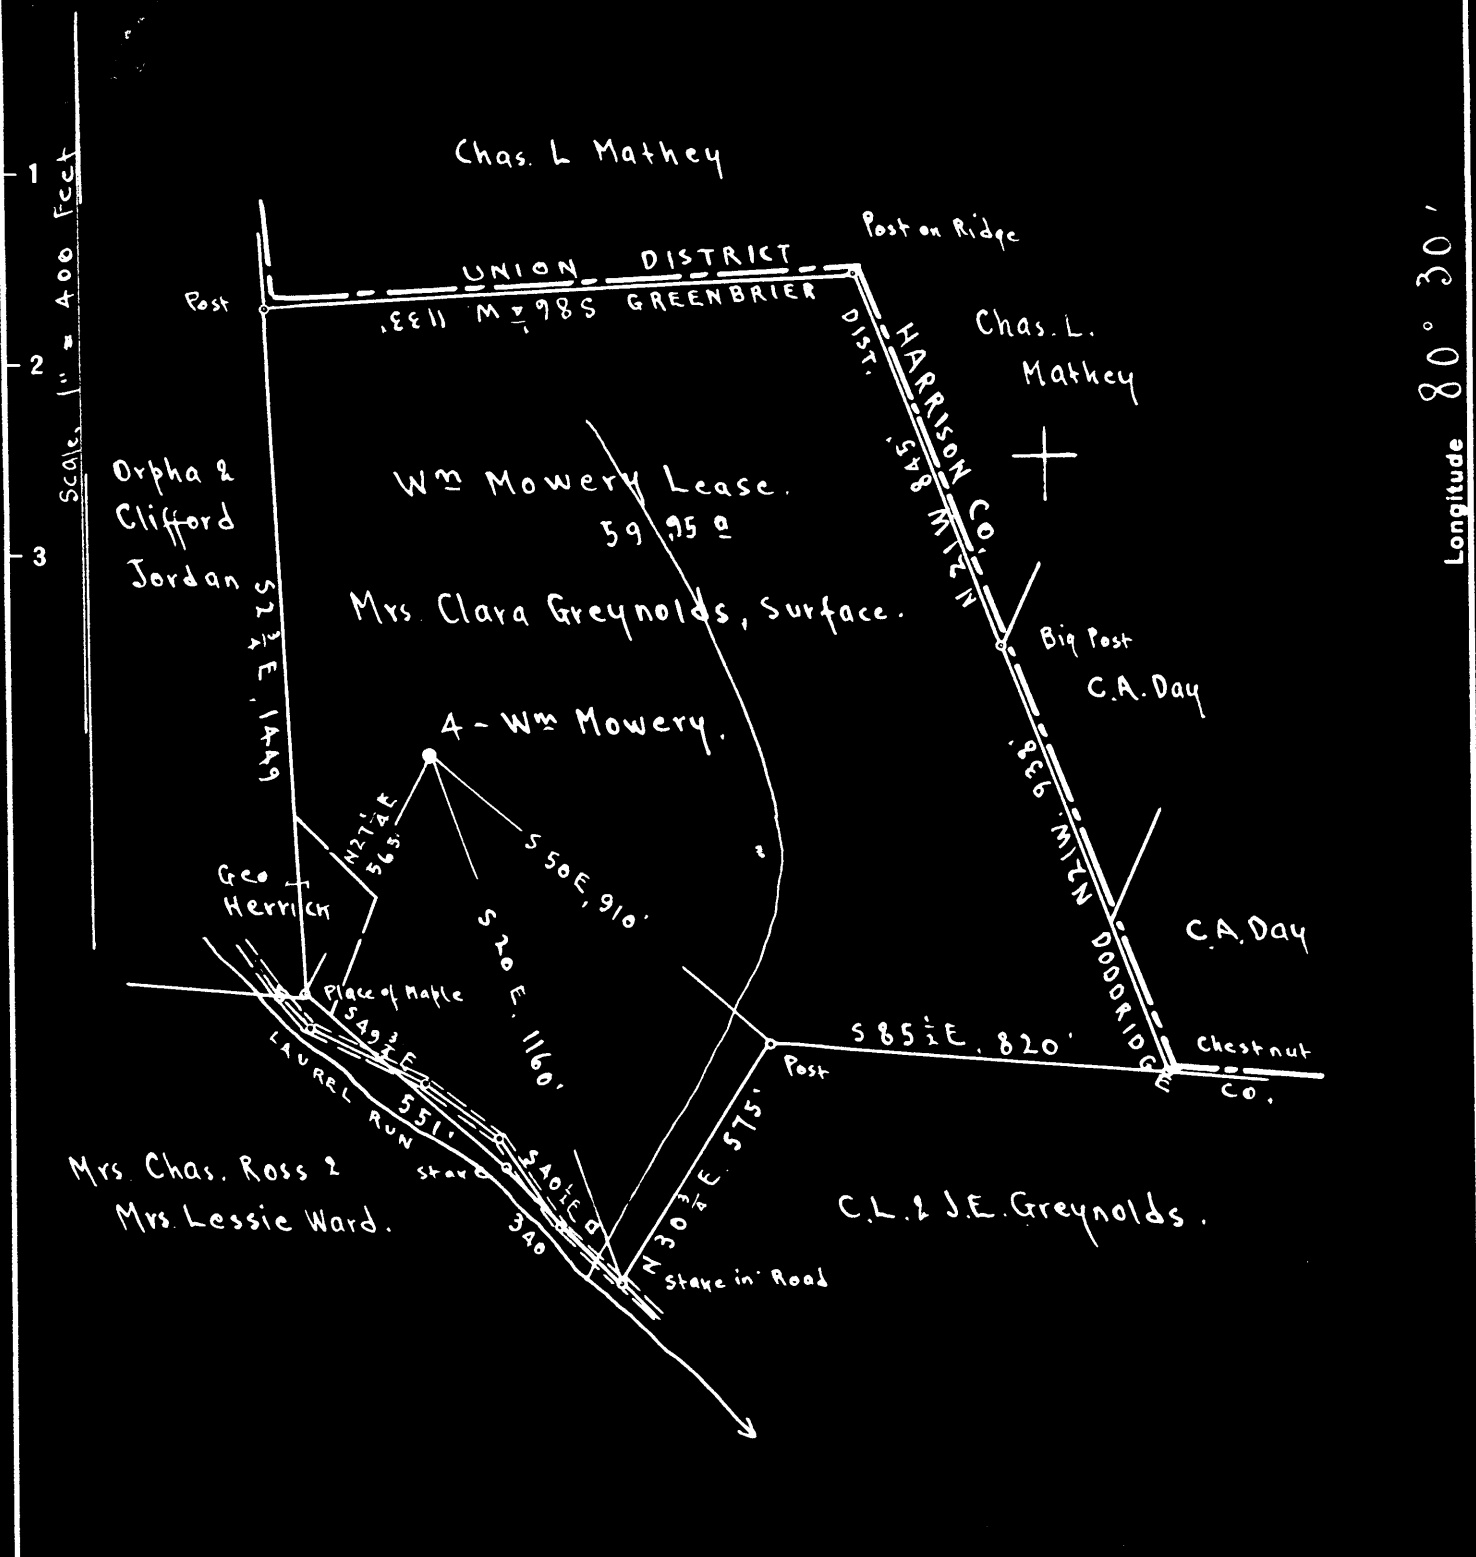

Surface: Mrs. Clara Greynolds, Box 3152, Ft. Neal Po., Parkersburg, W. Va.

Coal: State of West Virginia.

2.67 S
2.21 W

New Location
 Drill Deeper
 Abandonment On 400' map # 3852

S17 EA

Company Wm Moses
 Address Salem W. Va.
 Farm Wm Mowery
 Tract _____ Acres 60 Lease No. _____
 Well (Farm) No. 4 Serial No. _____
 Elevation (Spirit Level) Floor - 1214.00
 Ground - 1212.00
 Quadrangle VADIS
 County Doddridge District Greenbrier
 Engineer E. C. Tabler
 Engineer's Registration No. _____
 File No. _____ Drawing No. _____
 Date Aug 19th 1948 Scale 1" = 400 Feet

STATE OF WEST VIRGINIA
 DEPARTMENT OF MINES
 OIL AND GAS DIVISION
 CHARLESTON

WELL LOCATION MAP
 FILE NO. DOD-690-A

+ Denotes location of well on United States Topographic Maps, scale 1 to 62,500, latitude and longitude lines being represented by border lines as shown.

- Denotes one inch spaces on border line of original tracing.



STATE OF WEST VIRGINIA
DEPARTMENT OF MINES
OIL AND GAS DIVISION

586

WELL RECORD

Permit No. Ab 690-A

Oil or Gas Well Oil
(KIND)

Company William Moses
Address Salem, W. Va
Farm Wm Mowrey Acres 60
Location (waters) _____
Well No. Four Elev. 1212
District Greenbrier County Rockbridge
The surface of tract is owned in fee by South firm
Natl Gas Co. Address Parkersburg, W. Va.
Mineral rights are owned by State of W. Va
Address _____

Casing and Tubing	Used in Drilling	Left in Well	Packers
Size			Kind of Packer
16			
13			
10			Size of
8 1/4			
6 5/8		<u>2050</u>	Depth set
5 3/16		<u>2706</u>	
3			Perf. top
2			Perf. bottom
Liners Used			Perf. top
			Perf. bottom

Drilling commenced _____
Drilling completed 10/2/1901
Date Shot _____ From _____ To _____
With _____
Open Flow _____ /10ths Water in _____ Inch
_____ /10ths Merc. in _____ Inch
Volume _____ Cu. Ft.
Rock Pressure _____ lbs. _____ hrs.
Oil _____ bbls., 1st 24 hrs.
Fresh water _____ feet _____ feet
Salt water _____ feet _____ feet

CASING CEMENTED _____ SIZE _____ No. Ft. _____ Date _____
COAL WAS ENCOUNTERED AT 600 FEET _____ INCHES
_____ FEET _____ INCHES _____ FEET _____ INCHES
_____ FEET _____ INCHES _____ FEET _____ INCHES

Formation	Color	Hard or Soft	Top	Bottom	Oil, Gas or Water	Depth Found	Remarks
<u>Pitts coal</u>			<u>600</u>	<u>605</u>			
<u>Bunkard</u>			<u>1150</u>	<u>1200</u>			
<u>Maxon</u>			<u>1875</u>	<u>1900</u>			
<u>Big Injun</u>			<u>2050</u>	<u>2150</u>			
<u>Gordon Sand</u>			<u>2663</u>	<u>2675</u>			
<u>Fourth Sand</u>			<u>2736</u>	<u>2748</u>			
<u>Fifth Sand</u>			<u>2804</u>	<u>2910</u>			
<u>Total depth.</u>			<u>2936</u>				

