

Company Hope Natural Gas Co
 Address Clarksburg, W.Va.
 Farm Georgia S. Jones
 Tract _____ Acres 3 Lease No. 14365
 Well (Farm) No. _____ Serial No. 1211
 Elevation (Spirit Level) 790'
 Quadrangle Centerpoint SW
 County Doddridge District West Union
 Engineer W.M. Bowen
 Engineer's Registration No. 900
 File No. _____ Drawing No. _____
 Date 10-25-48 Scale 1" = 50'

STATE OF WEST VIRGINIA
 DEPARTMENT OF MINES
 OIL AND GAS DIVISION
 CHARLESTON

WELL LOCATION MAP
 FILE NO. DOD-706-A
#1211

+ Denotes location of well on United States Topographic Maps, scale 1 to 62,500, latitude and longitude lines being represented by border lines as shown.

- Denotes one inch spaces on border line of original tracing.



STATE OF WEST VIRGINIA
DEPARTMENT OF MINES
OIL AND GAS DIVISION

594

WELL RECORD

Permit No. 206-A


~~Oil~~ or Gas Well (KIND)

Company Hope Natural Gas Company.
 Address 445 West Main St. Clarksburg, W. Va.
 Farm Georgia S. Jones Acres 3
 Location (waters) _____
 Well No. 1211 Elev. 790
 District West Union County Dodderidge
 The surface of tract is owned in fee by _____
 Address _____
 Mineral rights are owned by _____
 Address _____
 Drilling commenced _____
 Drilling completed about 1905
 Date Shot From _____ To _____
 With _____
 Open Flow /10ths Water in _____ Inch
 /10ths Merc. in _____ Inch
 Volume _____ Cu. Ft.
 Rock Pressure _____ lbs. _____ hrs.
 Oil _____ bbls., 1st 24 hrs.
 Fresh water none recorded feet _____ feet
 Salt water none recorded feet _____ feet

Casing and Tubing	Used in Drilling	Left in Well	Packers
Size			Kind of Packer
16			
13			
10	100	Fulled	Size of
8 1/4	696	Pulled	
6 5/8	1511	1511	Depth set
5 3/16	1600	1600	
3			Perf. top
2			Perf. bottom
Liners Used			Perf. top
			Perf. bottom

NOT
 CASING CEMENTED SIZE No. Ft. Date
 not recorded
 COAL WAS ENCOUNTERED AT FEET INCHES
 FEET INCHES FEET INCHES
 FEET INCHES FEET INCHES

Formation	Color	Hard or Soft	Top	Bottom	Oil, Gas or Water	Depth Found	Remarks
Big Dunkard			685	695			
Salt sand				1286			
Big Lime				1514?			
Big Injun				1670	gas	1669	
Gantz			1840	1930			
Stray			2260	2270	gas	2263	
Gordon			2283		gas	2284	
Total depth				2310			

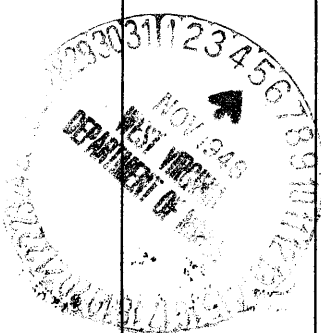

Formation	Color	Hard or Soft	Top	Bottom	Oil, Gas or Water	Depth Found	Remarks

Date November 3, 1948, 19

APPROVED Hops Natural Gas Company., Owner

By _____

(Title) *[Signature]*

West Union District, Doddridge County, W. Va.
 By Hope Natural Gas Co., 445 W. Main St., Clarksburg, W. Va.
 Abandoned under permit Dod-.....-A?
 On 3 acres.
 Elevation, 790' L.
 Drilling completed about 1905.
 No water recorded.
 10" casing, 100' (pulled); 8", 696' (pulled); 6", 1511'; 5", 1600'.
 Casing not cemented.
 No coal was recorded.
 Gas well. Abandonment reported to Dept. of Mines Nov. 3, 1948.
 Record to RCT from Mrs. Griffith Feb. 3, 1949. Old File No. 594.

	Top.	Bottom.
Big Dunkard Sand	685	- 695
Salt Sand	- 1286
Big Lime	- 1514?
Big Injun Sand (gas, 1669')	- 1670
Gantz Sand	1840	- 1930
Stray Sand (gas, 2263')	2260	- 2270
Gordon Sand (gas, 2284')	2283	-
Total depth		2310