

Latitude

15

Longitude 80 40



1.43 S
0.20 W

- New Location
- Drill Deeper
- Abandonment

Company SAM BEREN
 Address Marietta, Ohio
 Farm W. H. H. Douglas
 Tract Acres 213 Lease No. _____
 Well (Farm) No. Two Serial No. _____
 Elevation (Spirit Level) 1010
 Quadrangle Vadis
 County Doddridge District New Milton
 Engineer W. H. H. Douglas
 Engineer's Registration No. 1227
 File No. _____ Drawing No. _____
 Date Sept., 1948 Scale 1" = 800'

STATE OF WEST VIRGINIA
 DEPARTMENT OF MINES
 OIL AND GAS DIVISION
 CHARLESTON

WELL LOCATION MAP
 FILE NO. DOD-730-A

- + Denotes location of well on United States Topographic Maps, scale 1 to 62,500, latitude and longitude lines being represented by border lines as shown.
- Denotes one inch spaces on border line of original tracing.



STATE OF WEST VIRGINIA
DEPARTMENT OF MINES
OIL AND GAS DIVISION

611

WELL RECORD

Permit No. 730-A

Oil or Gas Well X (KIND)


Company Joe Rubin, S. Beren, A.H. Strauss
Address 2008 E. 7th St., Parkersburg, Va.
Farm W. H. H. Douglass Acres 138
Location (waters) _____
Well No. 42 Elev. 1010
District New Milton County Doddridge
The surface of tract is owned in fee by _____
Address _____
Mineral rights are owned by _____
Address _____
Drilling commenced _____
Drilling completed April 22, 1923
Date Shot _____ From _____ To _____
With _____
Open Flow _____ /10ths Water in _____ Inch
_____ /10ths Merc. in _____ Inch
Volume _____ Cu. Ft.
Rock Pressure _____ lbs. _____ hrs.
Oil _____ bbls., 1st 24 hrs.
Fresh water _____ feet _____ feet
Salt water _____ feet _____ feet

Casing and Tubing	Used in Drilling	Left in Well	Packers
Size			
16			Kind of Packer <u>H. W.</u>
13			<u>5 3/16" x 5</u>
10			Size of <u>5/8"</u>
8 1/4	<u>1332</u>	<u>1332</u>	<u>Shoe - 3 1/4"</u>
6 1/2	<u>2157</u>	<u>2157</u>	Depth set <u>6 5/8"</u>
5 3/16 <u>2205</u>	<u>2255</u>	<u>2255</u>	
3			Perf. top _____
2			Perf. bottom _____
Liners Used			Perf. top _____
			Perf. bottom _____

CASING CEMENTED _____ SIZE _____ No. Ft. _____ Date _____
COAL WAS ENCOUNTERED AT _____ FEET _____ INCHES
_____ FEET _____ INCHES FEET _____ INCHES
_____ FEET _____ INCHES FEET _____ INCHES

Formation	Color	Hard or Soft	Top	Bottom	Oil, Gas or Water	Depth Found	Remarks
Native Coal			223	233			
Water			350				
Fgh Coal			773	782			
Big Dunkard			1282	1373			
Water			1302				
Gas Sand			1523	1575			
1st Salt			1583	1642			
2nd Salt			1822	1911			
Water			1892				
Sand			1913	1961			
Maxon			2034	2053			
Little Lime			2085	2105			
Pencil Cave			2105	2126			
Big Lime			2130	2179			
Gas			2179	2181			
Big Injun			2182				
Oil			2206	2223			
Gas			2206	"			
Total Depth				2235			

(C)

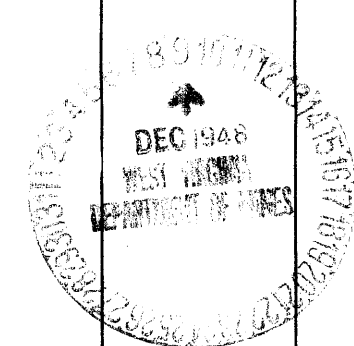

(Over)

MAY 21 1949