

#13	4.02	W
#16	2.29	S
#20	3.72	W
#21	2.30	S
#22	2.22	W

Surface owned by Charles Stewart Hrs.
 Address: Mrs. John Craig, 629, Mulberry Ave. Clarksburg, W. Va.
 No Coal ever sold under this tract of land, if any, it belongs to the owners of the surface.

New Location...
 Drill Deeper...
 Abandonment...

On 800' Map N37, Sqs. 54-5 W6-7.

Company Randall-Zogg Supply Co.
 Address Owensboro, Ky.
 Farm Charles Stewart
 Tract _____ Acres 446 1/2 Lease No. WCO
 Well (Farm) Nos. 13, 16 & 20 Serial No. _____
 Elevation (Spirit Level) see Wells above for Elev
 Quadrangle Centerpoint
 County Doddridge District Grant
 Engineer B.E. Krebs
 Engineer's Registration No. 9.
 File No. _____ Drawing No. _____
 Date June 1st, 1949. Scale 1" = 800 Feet

STATE OF WEST VIRGINIA
 DEPARTMENT OF MINES
 OIL AND GAS DIVISION
 CHARLESTON

WELL LOCATION MAP
 DOD-756-A-#13
 FILE NO. DOD-757-A-#16
 DOD-758-A-#20

+ Denotes location of well on United States Topographic Maps, scale 1 to 62,500, latitude and longitude lines being represented by border lines as shown.

- Denotes one inch spaces on border line of original tracing.



STATE OF WEST VIRGINIA
DEPARTMENT OF MINES
OIL AND GAS DIVISION

604

WELL RECORD

Permit No. 20 A

Oil or Gas Well **OIL**

(KIND)

Company RANDALL-ZOGG SUPPLY COMPANY
Address BOX 526, CHARLESTON, 22 W. VA.
Farm Charles Stewart Acres 446 1/2
Location (waters) Little Flint Creek
Well No. Twenty (20) Elev. 1100.02
District Grant County Doddridge

The surface of tract is owned in fee by Charles Stewart Hrs.
a/o Mrs. John Craig Address Clarksburg, W. Va.
Mineral rights are owned by Charles Stewart Hrs.
a/o Mrs. John Craig Address Clarksburg, W. Va.

Drilling commenced _____

Drilling completed _____

Date Shot SEE Below From _____ To _____

With _____

Open Flow /10ths Water in _____ Inch

/10ths Merc. in _____ Inch

Volume _____ Cu. Ft.

Rock Pressure _____ lbs. _____ hrs.

Oil _____ bbls., 1st 24 hrs.

Fresh water _____ feet _____ feet

Salt water _____ feet _____ feet

Casing and Tubing	Used in Drilling	Left in Well	Packers
Size			Kind of Packer
16			
13			
10	340'		Size of
8 1/4	1260'		
6 3/4	2120'	2120'	Depth set
5 3/16	942'	942'	
3			Perf. top
2	2263'	2263'	Perf. bottom
Liners Used			Perf. top
			Perf. bottom


CASING CEMENTED _____ SIZE _____ No. Ft. _____ Da _____

COAL WAS ENCOUNTERED AT 790 FEET _____ INCHES

_____ FEET _____ INCHES _____ FEET _____ INCHES

_____ FEET _____ INCHES _____ FEET _____ INCHES

Formation	Color	Hard or Soft	Top	Bottom	Oil, Gas or Water	Depth Found	Remarks
Pittsburgh Coal			790'				
Big Injun Sand			2110'		Oil	2225'	
Total Depth				2263'			
SHOT RECORD							
		<u>DATE OF SHOT</u>	<u>NO. QTS.</u>	<u>TOP OF SHOT</u>			
		8-2-97	20	2224'			
		12-13-98	30	2224'			
		1-12-05	40	2223'			
		7-3-11	60	2220'			

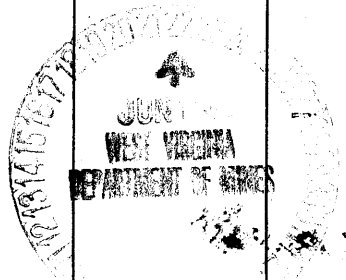

(Over)

SEP 27 1949

CHARLES STEWART NO. 20 WELL.

Grant District, Doddridge County, W. Va.

By Randall-Zogg Supply Co., Box 526, Charleston, 22, W. Va.

Abandoned under permit Dod-.....-A7

On 446 1/2 acres, on Little Flint Creek.

Elevation, 1100.02' L.

Surface and minerals owned by Charles Stewart Heirs, Mrs. John Craig, Clarksburg, W. Va.

Shot Aug. 2, 1897, with 20 qts., at 2224'; Dec. 13, 1898, with 30 qts., at 2224'; Jan. 12, 1905, with 40 qts., at 2223'; July 3, 1911, with 60 qts., at 2230' (tops of shots).

10" casing, 340' (pulled); 8 1/2", 1260'; 6", 2128'; 5", 948'; 2" tubing, 2263'.

Coal was encountered at 790'.

Oil well. Record to Dept. of Mines dated May 31, 1949.

Record to RGT from Mrs. Griffith September 27, 1949. Old File No. 664.

	Top.	Bottom.
Pittsburgh Coal	790 -	...
Big Injun Sand (oil, 2225')	2110 -
Total depth		2263