

#1 | 3.91 S  
| 4.46 W

---

#2 | 3.80 S  
| 4.41 W

Surface owned by Wilmer D. & Katherine J. Knight.  
 Address: Mr. Wilmer D. Knight, Washington, Wood Co. W. Va.  
 Coal never sold under this tract of land, if any, it belongs to the owners of the surface.

New Location...   
 Drill Deeper...   
 Abandonment...

On 800' Map N37. Sqs. 56 W 7-8.

Company Randall-Zogg Supply Co.  
 Address Owensboro, Ky.  
 Farm Henry Knight  
 Tract \_\_\_\_\_ Acres 110 Lease No. WC  
 Well (Farm) Nos. 1 & 2 Serial No. \_\_\_\_\_  
 Elevation (Spirit Level) See wells above for Elev  
 Quadrangle Centerpoint  
 County Doddridge District Grant  
 Engineer A. L. Headley  
 Engineer's Registration No. 2021  
 File No. \_\_\_\_\_ Drawing No. \_\_\_\_\_  
 Date June 1st, 1949. Scale 1" = 400 Feet

STATE OF WEST VIRGINIA  
 DEPARTMENT OF MINES  
 OIL AND GAS DIVISION  
 CHARLESTON

**WELL LOCATION MAP**

FILE NO. DOD - 768-A-#1  
DOD - 769-A-#2

+ Denotes location of well on United States Topographic Maps, scale 1 to 62,500, latitude and longitude lines being represented by border lines as shown.  
 - Denotes one inch spaces on border line of original tracing.



STATE OF WEST VIRGINIA  
DEPARTMENT OF MINES  
OIL AND GAS DIVISION

656

WELL RECORD

Permit No. 769A

Oil or Gas Well **OIL**  
(KIND)

Company RANDALL-ZOGG SUPPLY COMPANY  
Address BOX 526, CHARLESTON, 22 W. VA.  
Farm Henry Knight Acres 110  
Location (waters) \_\_\_\_\_  
Well No. Two (2) Elev. 1012-25  
District Grant County Doddridge  
The surface of tract is owned in fee by Wilmer D. & Katherine J. Knight Address Washington, W. Va.  
Mineral rights are owned by Wilmer D. & Katherine J. Knight Address Washington, W. Va.  
Drilling commenced \_\_\_\_\_  
Drilling completed \_\_\_\_\_  
Date Shot SEE BELOW From \_\_\_\_\_ To \_\_\_\_\_  
With \_\_\_\_\_

Open Flow /10ths Water in \_\_\_\_\_ Inch  
/10ths Merc. in \_\_\_\_\_ Inch  
Volume \_\_\_\_\_ Cu. Ft.  
Rock Pressure \_\_\_\_\_ lbs. \_\_\_\_\_ hrs.  
Oil \_\_\_\_\_ bbls., 1st 24 hrs.  
Fresh water \_\_\_\_\_ feet \_\_\_\_\_ feet  
Salt water \_\_\_\_\_ feet \_\_\_\_\_ feet

Casing and Tubing	Used in Drilling	Left in Well	Packers
Size			
16			Kind of Packer
13			
10	120'	16'	Size of
8 1/2	950'		
6 1/2	2068	2068'	Depth set
5 3/16	2068'	2 068'	
3 1/2"	2046'	2046'	Perf. top
2	2139'	2139'	Perf. bottom
Liners Used			Perf. top
			Perf. bottom

CASING CEMENTED \_\_\_\_\_ SIZE \_\_\_\_\_ No. Ft. \_\_\_\_\_ Dat \_\_\_\_\_

COAL WAS ENCOUNTERED AT 700 FEET INCHES  
\_\_\_\_\_ FEET INCHES FEET INCHES  
\_\_\_\_\_ FEET INCHES FEET INCHES


Formation	Color	Hard or Soft	Top	Bottom	Oil, Gas or Water	Depth Found	Remarks
Pittsburgh Coal			700'				
Big Injun Sand			2046'		Oil & Gas Oil	2116' 2127'	
Total Depth				2139'			

SHOT RECORD

<u>DATE OF SHOT</u>	<u>NO. QTS.</u>	<u>TOP OF SHOT</u>
5-5-96	12	2124'
8-2-99	16	2125'
2-21-03	20	2125'
7-26-04	24	2124'
5-30-08	40	2126'

NOTE:

The 6-5/8" and 10" casing could not be located at well.

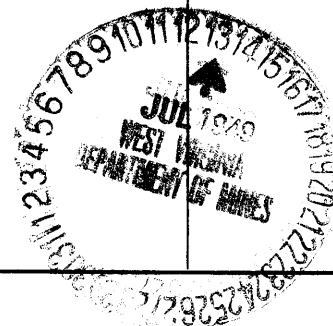

(Over)

SEP 27 1949



HENRY KNIGHT NO. 2 WELL.

Grant District, Doddridge County, W. Va.  
By Randall-Egg Supply Co., Box 526, Charleston, 22, W. Va.  
Abandoned under permit No. ....-A?  
On 110 acres.

Elevation, 1012.25' L.

Surface and minerals owned by Wilmer D. and Katherine J. Knight,  
Washington, W. Va.

Shot May 5, 1898, with 12 qts., top of shot, 2124'; Aug. 2, 1899,  
with 16 qts., top of shot, 2125'; Feb. 21, 1903, with 20 qts.,  
top of shot, 2125'; July 26, 1904, with 24 qts., top of shot, 2124';  
Nov 30, 1908, with 40 qts., top of shot, 2126'.  
10" casing, 190' (16' left in); 8", 950' (pulled); 6", 2068';  
5", 2088'; 4" tubing, 2046'; 2", 2139'.

Coal was encountered at 700'.

Oil well. Record to Dept. of Mines dated June 9, 1949.

Record to RCT from Mrs. Griffith September 27, 1949. Old file No. 656.

NOTE: The 6" and 10" casing could not be located at well.

	Top.	Bottom.
Pittsburgh Coal	700 -	...
Big Injun Sand (oil and gas, 2116') (oil, 2127')	2048 -	....
Total depth		2139