

New Location
 Drill Deeper
 Abandonment

Map Sheet 54 Squares S8 E2 FB 548 P 31-32

Company HOPE NATURAL GAS CO.
 Address CLARKSBURG, W. VA
 Farm CHESTER DAVIS
 Tract _____ Acres 41 Lease No. 3430
 Well (Farm) No. _____ Serial No. 934
 Elevation (Spirit Level) 933
 Quadrangle CENTERPOINT
 County DODDRIDGE District McCLELLAN
 Engineer W. M. Bowers
 Engineer's Registration No. 900
 File No. _____ Drawing No. _____
 Date AUGUST 19, 1949 Scale 1" = 20P

STATE OF WEST VIRGINIA
 DEPARTMENT OF MINES
 OIL AND GAS DIVISION
 CHARLESTON

WELL LOCATION MAP
 FILE NO. DOD-790-A

+ Denotes location of well on United States Topographic Maps, scale 1 to 62,500, latitude and longitude lines being represented by border lines as shown.

- Denotes one inch spaces on border line of original tracing.



STATE OF WEST VIRGINIA
DEPARTMENT OF MINES
OIL AND GAS DIVISION

650

WELL RECORD

Permit No. 190-A

Oil or Gas Well XXXXXX (KIND)


Company Hope Natural Gas Company.
Address 445 West Main St., Clarksburg, W. Va.
Farm Chester Davis Acres 41
Location (waters) _____
Well No. 934 Elev. 933
District McClellan County Doddridge
The surface of tract is owned in fee by _____
Address _____
Mineral rights are owned by _____
Address _____
Drilling commenced February 28, 1907
Drilling completed April 16, 1907
Date Shot _____ From _____ To _____
With _____
Open Flow _____ /10ths Water in _____ Inch
_____ /10ths Merc. in _____ Inch
Volume _____ Cu. Ft.
Rock Pressure _____ lbs. _____ hrs.
Oil _____ bbls., 1st 24 hrs.
Fresh water none recorded feet _____ feet
Salt water none recorded feet _____ feet

Casing and Tubing	Used in Drilling	Left in Well	Packers
Size			
16			Kind of Packer
13			
10	284	284	Size of
8 1/4	1222	Pulled	
6 5/8	2123	2123	Depth set
5 3/16	2593	2593	
3			Perf. top
2			Perf. bottom
Liners Used			Perf. top
			Perf. bottom

CASING CEMENTED NOT SIZE _____ No. Ft. _____

COAL WAS ENCOUNTERED AT 410 FEET 60? INCHES
696 FEET 108 INCHES FEET INCHES
FEET INCHES FEET INCHES

Formation	Color	Hard or Soft	Top	Bottom	Oil, Gas or Water	Depth Found	Remarks
Coal			410	415 Est			
Pitts. Coal			696	705			
Little Dunkard			1100	1140			
Big Dunkard			1205	1250			
Gas sand			1440	1478			
Salt sand			1570	1700			
Maxon			1783	1823			
Little Line			1880	1920			
Big Line			1938	1989			
Big Injun			1989	2087			
Berea			2230	2255			
Gantz			2430	2450			
Fifty foot			2560	2572			
Thirty foot			2670	2689			
Gordon stray			2740	2768	gas	2748	
Total depth Drilled deeper				2775			
Gordon			2794	2800	show oil-gas	2795	
Total depth				2950			

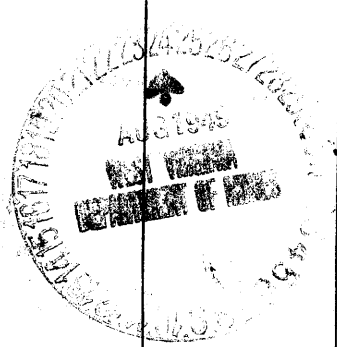

Formation	Color	Hard or Soft	Top	Bottom	Oil, Gas or Water	Depth Found	Remarks

Date August 23, 1949, 19

APPROVED Hope Natural Gas Company., Owner

By _____

(Title) *[Signature]*

McClellan District, Doddridge County, W. Va.

By Hope Natural Gas Co., 445 W. Main St., Clarksburg, W. Va.

Abandoned under permit No.-A?

On 41 acres.

Elevation, 933' L.

Drilling commenced Feb. 28, 1907; completed April 16, 1907.

No water recorded.

10" casing, 284'; 8 1/2", 1222' (pulled); 6 1/2", 2123'; 5 1/2", 2593'.

Casing not cemented.

Coal was encountered at 410-415' and 696-705'.

Gas? well. Record to Dept. of Mines dated August 23, 1949.

Record to RCT from Mrs. Griffith September 27, 1949. Old File No. 650.

	Top.	Bottom.
Coal	410 -	(415) (Est.)
Pittsburgh Coal	696 -	705
Little Dunkard Sand	1100 -	1140
Big Dunkard Sand	1205 -	1250
Gas Sand	1440 -	1478
Salt Sand	1570 -	1700
Maxton Sand	1783 -	1823
Little Lime	1880 -	1920
Big Lime	1938 -	1989
Big Injun Sand	1989 -	2087
Berea Sand	2230 -	2255
Gantz Sand	2430 -	2450
Fifty-foot Sand	2560 -	2572
Thirty-foot Sand	2670 -	2689
Gordon Stray Sand (gas, 2748')	2740 -	2768
Total depth		2775
DRILLED DEEPER:		
Gordon Sand (show oil-gas, 2795')	2794 -
Total depth		2950