

Map Sh 45 S6 E1 FB. 548 P-6-7-10.

Company Hope Natural Gas Co.  
 Address Clarksburg, W. Va.  
 Farm Chas. G. Schutte  
 Tract \_\_\_\_\_ Acres 35.0 Lease No. 621  
 Well (Farm) No. \_\_\_\_\_ Serial No. As Shown  
 Elevation (Spirit Level) As Shown  
 Quadrangle Centerpoint  
 County Doddridge District McClellan  
 Engineer Wm Bowers  
 Engineer's Registration No. 900  
 File No. \_\_\_\_\_ Drawing No. \_\_\_\_\_  
 Date 2-20-50 Scale 1" = 40'

STATE OF WEST VIRGINIA  
 DEPARTMENT OF MINES  
 OIL AND GAS DIVISION  
 CHARLESTON

**WELL LOCATION MAP**  
 FILE NO. DOD-812-A-#264

+ Denotes location of well on United States Topographic Maps, scale 1 to 62,500, latitude and longitude lines being represented by border lines as shown.

- Denotes one inch spaces on border line of original tracing.

"IMPERIAL" TRACING CLOTH  
 K & E CO., N. Y.



STATE OF WEST VIRGINIA  
DEPARTMENT OF MINES  
OIL AND GAS DIVISION

707

WELL RECORD

Permit No. 860 - 812 - A

~~Oil~~ Gas Well (KIND)

Company Hope Natural Gas Company  
Address 445 West Main St. Clarksburg, W. Va.  
Farm Chas. G. Schutte Acres 350  
Location (waters) \_\_\_\_\_  
Well No. 264 Elev. 825  
District McClellan County Doddridge  
The surface of tract is owned in fee by \_\_\_\_\_  
Address \_\_\_\_\_  
Mineral rights are owned by \_\_\_\_\_  
Address \_\_\_\_\_

Drilling commenced \_\_\_\_\_  
Drilling completed about 1901  
Date Shot \_\_\_\_\_ From \_\_\_\_\_ To \_\_\_\_\_  
With \_\_\_\_\_  
Open Flow \_\_\_\_\_ /10ths Water in \_\_\_\_\_ Inch  
\_\_\_\_\_ /10ths Merc. in \_\_\_\_\_ Inch  
Volume \_\_\_\_\_ Cu. Ft.  
Rock Pressure \_\_\_\_\_ lbs. \_\_\_\_\_ hrs.  
Oil \_\_\_\_\_ bbls., 1st 24 hrs.  
Fresh water none recorded feet \_\_\_\_\_ feet  
Salt water none recorded feet \_\_\_\_\_ feet


Casing and Tubing	Used in Drilling	Left in Well	Packers
Size			
16			Kind of Packer
13	30	30	
10	285	285	Size of
8 1/4	910	910	
6 5/8	1780	1179	Depth set
5 3/16	1848	1848	
3			Perf. top
2			Perf. bottom
Liners Used			Perf. top
			Perf. bottom

NOT CASING CEMENTED \_\_\_\_\_ SIZE \_\_\_\_\_ No. Ft. \_\_\_\_\_ Date \_\_\_\_\_

COAL WAS ENCOUNTERED AT 438 FEET 120 INCHES  
\_\_\_\_\_ FEET \_\_\_\_\_ INCHES FEET \_\_\_\_\_ INCHES  
\_\_\_\_\_ FEET \_\_\_\_\_ INCHES FEET \_\_\_\_\_ INCHES

Formation	Color	Hard or Soft	Top	Bottom	Oil, Gas or Water	Depth Found	Remarks
Pittsburgh Coal			438	448			
Big Injun			1780	1885			
Gordon			2550		gas	2552	
Total depth				2595			

7

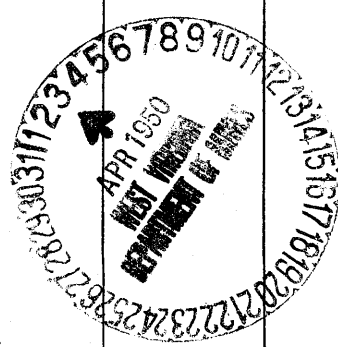


(Over) MAY 26 1950

Formation	Color	Hard or Soft	Top	Bottom	Oil, Gas or Water	Depth Found	Remarks

Date February 28, 1950, 19

APPROVED Hope Natural Gas Company, Owner

By \_\_\_\_\_

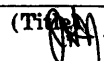(Type Name)  


CHAS. G. SCHUTES NO. 264 WELL.

McClellan District, Doddridge County, W. Va.  
By Hope Natural Gas Co., 445 W. Main St., Clarksburg, W. Va.  
Abandoned under permit No. ....-A?

Odds  
(enplat 24-F  
new 109)

On 350 acres.  
Elevation, 825' L.  
Drilling completed about 1901.

No water recorded.  
13" casing, 30'; 10" casing, 285'; 8 1/2" casing, 910'; 6 3/4" casing, 1780'; 5 1/2" casing, 1848'; all left in.  
Casing was not cemented.

Coal was encountered at 438-448'.  
Gas well. Record to Dept. of Mines dated Feb. 28, 1950.  
Record to RGT from Mrs. Griffith May 26, 1950. Old File No. 707.

	Top.	Bottom.
Pittsburgh Coal	438	448
Big Injun Sand	1780	1885
Garden Sand (gas, 2552')	2550	....
Total depth		2595

