

Surface owned by Orpha S. Jordan.
 Address: Mrs. Orpha S. Jordan, R.F.D. No. 2, Bristol, W. Va.
 Coal owned by Virginia A. Tetrick, et al.
 Address: Mrs. Virginia A. Tetrick, P.O. Box 267, Clarksburg, W. Va.

- New Location...
- Drill Deeper...
- Abandonment...

On 800' Map N19. Sqs. S17 E4.

Company William Moses
 Address Salem, W. Va.
 Farm Wm. Ward
 Tract _____ Acres 100 Lease No. _____
 Well (Farm) No. 2 Serial No. _____
 Elevation (Spirit Level) Floor - 1193.00
Ground - 1190.20
 Quadrangle Vadis
 County Doddridge District Greenbrier
 Engineer Elworth Haines
 Engineer's Registration No. 2221
 File No. _____ Drawing No. _____
 Date Feb. 22nd, 1950 Scale 1" = 400 Feet

STATE OF WEST VIRGINIA
 DEPARTMENT OF MINES
 OIL AND GAS DIVISION
 CHARLESTON

WELL LOCATION MAP
 FILE NO. DOD-814-A

- + Denotes location of well on United States Topographic Maps, scale 1 to 62,500, latitude and longitude lines being represented by border lines as shown.
- Denotes one inch spaces on border line of original tracing.

Total Depth

2924



709

STATE OF WEST VIRGINIA
DEPARTMENT OF MINES
OIL AND GAS DIVISION

WELL RECORD

Permit No. 000-814 - A


Oil or Gas Well Oil
(KIND)

Company William Moses
 Address Salem, W. Va.
 Farm Wm. Ward Acres 100
 Location (waters) _____
 Well No. Two Elev 190.20
 District Greenbrier County Doddridge
 The surface of tract is owned in fee by South Penn Nat'l. Gas Co. Address Parkersburg, W. Va.
 Mineral rights are owned by Virginia A. Tetrick, et al. P. O. 267 Address Clarksburg, W. Va.
 Drilling commenced ?
 Drilling completed 4/17/02
 Date Shot _____ From _____ To _____
 With _____
 Open Flow _____ /10ths Water in _____ Inch
 _____ /10ths Merc. in _____ Inch
 Volume _____ Cu. Ft.
 Rock Pressure _____ lbs. _____ hrs.
 Oil _____ bbls., 1st 24 hrs.
 Fresh water _____ feet
 Salt water _____ feet

Casing and Tubing	Used in Drilling	Left in Well	Packers
Size			
16			Kind of Packer
13			
10			Size of
		2040	Depth set
			Perf. top
			Perf. bottom
Liners Used			Perf. top
			Perf. bottom

CASING CEMENTED _____ SIZE _____ No. Ft. _____ Date _____
 COAL WAS ENCOUNTERED AT 607 FEET _____ INCHES
 _____ FEET _____ INCHES FEET _____ INCHES
 _____ FEET _____ INCHES FEET _____ INCHES

Formation	Color	Hard or Soft	Top	Bottom	Oil, Gas or Water	Depth Found	Remarks
Pittsburgh Coal			607	612			
Dunkard Sand			1115	1175			
Big Lime			1975	2000			
Big Injun			2057	2130			
Stray Sand			2686	2705			
Gordon Sand			2720	2750			
Fifth Sand			2904	2907			
Total Depth			2924				

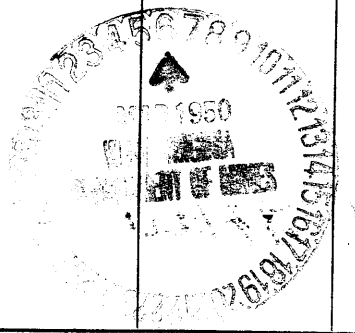

(Over)

MAY 26 1950