

Latitude 39° 10'

Longitude 80° 45'

S 1.25
W 4.07

New Location...
 Drill Deeper...
 Abandonment...

Company JAMES R. KOOKEN
 Address PENNSBORO, W. VA.
 Farm W. R. BROWN
 Tract _____ Acres 20 Lease No. _____
 Well (Farm) No. 1 Serial No. _____
 Elevation (Spirit Level) 1083
 Quadrangle HOLBROOK
 County DODDRIDGE District SOUTHWEST
 Engineer B. F. RINEHART **EC**
 Engineer's Registration No. 648
 File No. _____ Drawing No. 784-5D
 Date Sept. 26, 1950 Scale 1 in. = 300 ft.

STATE OF WEST VIRGINIA
 DEPARTMENT OF MINES
 OIL AND GAS DIVISION
 CHARLESTON

WELL LOCATION MAP
 FILE NO. DOD-850-A

+ Denotes location of well on United States Topographic Maps, scale 1 to 62,500, latitude and longitude lines being represented by border lines as shown.

- Denotes one inch spaces on border line of original tracing.



745

STATE OF WEST VIRGINIA
DEPARTMENT OF MINES
OIL AND GAS DIVISION

WELL RECORD

Permit No. 850-A


Oil or Gas Well Gas
(KIND)

Company J. R. Kooken
 Address Pennsboro, W. Va.
 Farm W. R. Brown Acres 20
 Location (waters) Straight Fork, Hughes River
 Well No. 1 Elev. 1083
 District Southwest County Woodridge
 The surface of tract is owned in fee by _____
 Address _____
 Mineral rights are owned by _____
 Address _____
 Drilling commenced _____
 Drilling completed 1925
 Date Shot _____ From _____ To _____
 With _____
 Open Flow _____ /10ths Water in _____ Inch
 _____ /10ths Merc. in _____ Inch
 Volume _____ Cu. Ft.
 Rock Pressure _____ lbs. _____ hrs.
 Oil _____ bbls., 1st 24 hrs.
 Fresh water _____ feet _____ feet
 Salt water _____ feet _____ feet

Casing and Tubing	Used in Drilling	Left in Well	Packers
Size			
16			Kind of Packer
13			
10	450	450	Size of
8 1/4	1200	1200	
6 1/2	1700	1700	Depth set
5 3/16			
3	1875	1875	Perf. top
2			Perf. bottom
Liners Used			Perf. top
			Perf. bottom

CASING CEMENTED _____ SIZE _____ No. Ft. _____ Da _____
 COAL WAS ENCOUNTERED AT _____ FEET _____ INCH
 _____ FEET _____ INCHES _____ FEET _____ INCH
 _____ FEET _____ INCHES _____ FEET _____ INCH

Formation	Color	Hard or Soft	Top	Bottom	Oil, Gas or Water	Depth Found	Remarks
Horse Neck Sand			855	885			
Little Dunkard			905	950			
Big Dunkard			1095	1251			
Gas Sand			1195	1245			
1st salt sand			1410	1505			
3rd salt sand			1612	1640	Gas	1615	
Big Injun			1856	1875	Gas	1862-1875	

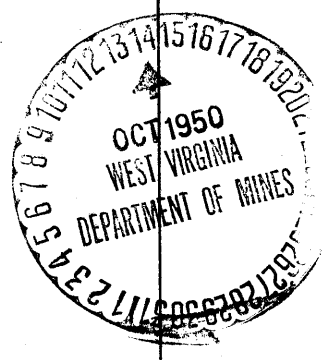

FEB 23 1951

Formation	Color	Hard or Soft	Top	Bottom	Oil, Gas or Water	Depth Found	Remarks

Date Oct 12, 195

APPROVED J.P. [Signature], Own

By _____ (Title)