

New Location
 Drill Deeper
 Abandonment

FFR 18 1952

Company Glenn F. Mc Burney
 Address Box 114 Sistersville, W. Va.
 Farm Cassie Reese
 Tract _____ Acres 12 1/2 Lease No. _____
 Well (Farm) No. 1 Serial No. _____
 Elevation (Spirit Level) 890
 Quadrangle Holbrook
 County Woddrige District Central
 Engineer Robert R. Anderson
By Jno. Triplett, Surveyor.
 Engineer's Registration No. 296
 File No. _____ Drawing No. _____
 Date Jan. 6 1951 Scale 1" = 10 P.

STATE OF WEST VIRGINIA
 DEPARTMENT OF MINES
 OIL AND GAS DIVISION
 CHARLESTON

WELL LOCATION MAP
 FILE NO. DOD-859-A

+ Denotes location of well on United States Topographic Maps, scale 1 to 62,500, latitude and longitude lines being represented by border lines as shown.
 - Denotes one inch spaces on border line of original tracing.



158

STATE OF WEST VIRGINIA
DEPARTMENT OF MINES
OIL AND GAS DIVISION

WELL RECORD

Permit No. 000-859-A

Oil or Gas Well Oil

(KIND)

Company Glenn F. McBurney
Address Box 114 Sistersville, W.Va.
Farm Cassie Reese Acres 12 1/2
Location (waters) Leason run
Well No. 1 Elev. 890
District Central County Doddridge
The surface of tract is owned in fee by Cassie Reese
Address Greenwood, W.Va
Mineral rights are owned by Cassie Reese
Address Greenwood, W.Va
Drilling commenced May 18th, 1924
Drilling completed July 12th, 1924
Date Shot July 12-24 From 1978 To 1990
With 15 quarts
Open Flow /10ths Water in _____ Inch
/10ths Merc. in _____ Inch
Volume _____ Cu. Ft.
Rock Pressure _____ lbs. _____ hrs.
Oil 175 barrels bbls., 1st 24 hrs.
Fresh water 90 feet feet
Salt water small with oil feet

Casing and Tubing	Used in Drilling	Left in Well	Packers
16	16 feet wood conductors		Packer
13			
10	160 feet pulled		Size of
8 1/4	1100 feet pulled		
6%	1666 "		Depth set
5 3/16			
3	1992	tubing	Perf. top 1976
2			Perf. bottom 1992
Liners Used			Perf. top
			Perf. bottom


CASING CEMENTED _____ SIZE _____ No. Ft. _____ Date _____

COAL WAS ENCOUNTERED AT NONE FEET _____ INCHES

_____ FEET _____ INCHES _____ FEET _____ INCHES

_____ FEET _____ INCHES _____ FEET _____ INCHES

Formation	Color	Hard or Soft	Top	Bottom	Oil, Gas or Water	Depth Found	Remarks
Gray Sand	L. Dunkard	Hard	618	630			
red sand	B. Dunkard	Hard	982	1021			
Sand	Brown	hard	1082	1101			
Gray sand	Gray	hard	1123	1160			
sand	Brown	hard	1550	1653			
sand	Brown	med	1658	1695			
sand	white	hard	1800	1818			
sand	Brown	soft	1820	1828			
lime	white	hard	1830	1850			
shale	brown	hard	1850	1863			
lime	white	hard	1863	1948			
BI sand	brown	med	1848	1992	oil	1945 to 1967	
				1992	total depth		

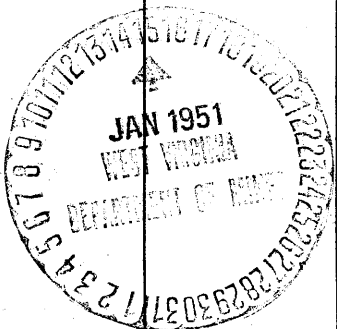

Formation	Color	Hard or Soft	Top	Bottom	Oil, Gas or Water	Depth Found	Remarks

8

Date Jan 12 th, 1951

APPROVED Glen F. McBurney, Owner

By Glen F. McBurney - owner
(Title)

Central District, Heddrige County, W. Va.
 By Glenn F. McBurney, Box 114, Sistersville, W. Va.
 Abandoned under permit 1nd-.....
 On 12½ acres, on Leason Run.
 Elevation,
 Surface and minerals owned by Caesie Reese, Greenwood, W. Va.
 Drilling commenced May 18, 1924; completed July 12, 1924.
 Shut July 12, 1924, at 1978-1990', with 15 qts.
 Oil, 175 bbls., 1st 24 hrs.
 Fresh water, 90', small, with oil. (?)
 16" wood conductor, 16'; 10" casing, 160' (pulled); 8½", 1100' (pulled);
 6", 1666'; 3" tubing, 1992'.
 Perf. top, 1976'; perf. bot., 1992'.
 Oil well. Record to Dept. of Mines dated Jan. 12, 1951.
 Record to RCF from Mrs. Griffith June 24, 1951. Old File No. 758.

	Top.	Bottom.
Gray sand, Little Dunkard, hard	618	- 630
Red sand, Big Dunkard, hard	982	- 1021
Sand, brown, hard	1082	- 1101
Gray sand, hard	1123	- 1160
Sand, brown, hard	1550	- 1653
Sand, brown, medium	1658	- 1695
Sand, white, hard	1800	- 1818
Sand, brown, soft	1820	- 1828
Lime, white, hard	1830	- 1850
Shale, brown, hard	1850	- 1863
Lime, white, hard	1863	- 1948
Sand, brown, medium (oil, 1945- 1967')	1848	- 1992
Total depth		1992