

#1	3.38 W
	3.7 Q
#2	3.6 W
	3.73 Q

New Location...
 Drill Deeper.....
 Abandonment.....

FEB 18 1952

Company JAMES R. KOOKEN
 Address PENNSBORO, W. VA.
 Farm M. SHUTTLESWORTH
 Tract _____ Acres 40 Lease No. _____
 Well (Farm) No. 1 & 2 Serial No. _____
 Elevation (Spirit Level) 945.3 & 1051
 Quadrangle WEST UNION
 County No. 1 DODDRIDGE District CENTRAL CLAY
 County No. 2 RITCHIE District _____
 Engineer B. F. RINEHART
 Engineer's Registration No. 648
 File No. _____ Drawing No. 800-CR
 Date Jan. 29, 1951 Scale 1 in. = 400 ft.

STATE OF WEST VIRGINIA
 DEPARTMENT OF MINES
 OIL AND GAS DIVISION
 CHARLESTON

WELL LOCATION MAP
 FILE NO. DOD-860-A-#1

+ Denotes location of well on United States Topographic Maps, scale 1 to 62,500, latitude and longitude lines being represented by border lines as shown.

- Denotes one inch spaces on border line of original tracing.



759

STATE OF WEST VIRGINIA
DEPARTMENT OF MINES
OIL AND GAS DIVISION

WELL RECORD

Permit No. 900-860-A

Oil or Gas Well Gas
(KIND)


Company J. R. Kooken
 Address Pennsboro, W. Va.
 Farm M. Shuilsworth Acres 40
 Location (waters) Yeager's Run
 Well No. 1 Elev. 945.3
 District Central County Dodderidge
 The surface of tract is owned in fee by G. & W. J. Leason
 Address Greenwood, W. Va.
 Mineral rights are owned by Consumers Gas Co.
 Address Pennsboro, W. Va.
 Drilling commenced _____
 Drilling completed 1951
 Date Shot _____ From _____ To _____
 With _____
 Open Flow _____ /10ths Water in _____ Inch
 _____ /10ths Merc. in _____ Inch
 Volume _____ Cu. Ft.
 Rock Pressure _____ lbs. _____ hrs.
 Oil _____ bbls., 1st 24 hrs.
 Fresh water _____ feet _____ feet
 Salt water _____ feet _____ feet

Casing and Tubing	Used in Drilling	Left in Well	Packers
Size			
16			Kind of Packer
13			
10	342	0	Size of
8 1/2	1079	0	
6	1444	1444	Depth set
5 3/16			
3			Perf. top
2	2003	2003	Perf. bottom
Liners Used			Perf. top
			Perf. bottom

CASING CEMENTED _____ SIZE _____ No. Ft. _____ Date _____

COAL WAS ENCOUNTERED AT _____ FEET _____ INCHES
 _____ FEET _____ INCHES FEET _____ INCHES
 _____ FEET _____ INCHES FEET _____ INCHES

Formation	Color	Hard or Soft	Top	Bottom	Oil, Gas or Water	Depth Found	Remarks
Maxon			1742	1768			
Big Lime			1909	1971			
Big Injun			1971				
Total Depth				2013			

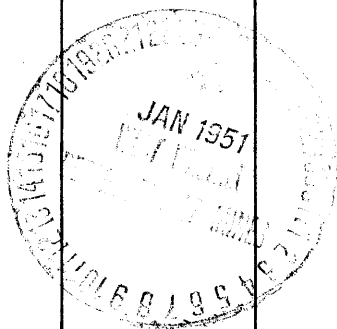

(Over)

JUN 24 1951

Formation	Color	Hard or Soft	Top	Bottom	Oil, Gas or Water	Depth Found	Remarks

Date Jan 18, 1957

APPROVED J.P. [Signature], Owner

By [Signature] (Title)

H. SHUTTLESWORTH NO. 1 WELL.

860A

70462

Central District, Faldridge County, W. Va.

By J. H. Kookan, Fennsboro, W. Va.

Abandoned under permit No.-17

On 40 acres, on Yeagers Run.

Elevation, 945.3' L.

Surface owned by C. and H. J. Leeson, Greenwood, W. Va., and minerals

by Consumers Gas Co., Fennsboro, W. Va.

Drilling completed in 1913.

10" casing, 342' (pulled); 8", 1079' (pulled); 6", 1444'; 2" tubing, 2003'

Gas well. Record to Dept. of Mines dated Jan. 15, 1951.

Record to RCT from Mrs. Griffith June 24, 1951. Old File No. 759.

	Top.	Bottom.
Horton Sand	1742	- 1768
Big Line	1909	- 1971
Big Injun Sand	1971	-
Total depth		2013