

New Location
 Drill Deeper
 Abandonment

✓ FEB 18 1952

2.8 W
 4.09 Q

Company	VALLEY STEEL PRODUCTS CO.	
Address	ST. LOUIS, MO.	
Farm	W. A. DUCKWORTH HRS.	
Tract	Acres 1	Lease No.
Well (Farm) No.	1	Serial No.
Elevation (Spirit Level)	844	
Quadrangle	WEST UNION	
County	DODDRIDGE	District CENTRAL
Engineer	B. F. RINEHART	
Engineer's Registration No.	648	
File No.	Drawing No. 806-CD	
Date	Feb. 24, 1952	Scale 1" = 100'

STATE OF WEST VIRGINIA
 DEPARTMENT OF MINES
 OIL AND GAS DIVISION
 CHARLESTON

WELL LOCATION MAP
 FILE NO. DOD-865-A

+ Denotes location of well on United States Topographic Maps, scale 1 to 62,500, latitude and longitude lines being represented by border lines as shown.

- Denotes one inch spaces on border line of original tracing.

W. A. DUCKWORTH HRS. (No. 1) - VALLEY STEEL PRODUCTS CO. - DOD-865-A



STATE OF WEST VIRGINIA
DEPARTMENT OF MINES
OIL AND GAS DIVISION

763

Permit No. 000-865-A

WELL RECORD

Oil or Gas Well X (KIND)


Company Valley Steel Products Company
Address St. Louis, Mo.
Farm W. A. Duckworth Acres 1
Location (waters) _____
Well No. 1 Elev. 844'
District Central County Doddridge
The surface of tract is owned in fee by _____
Address _____
Mineral rights are owned by _____
Address _____
Drilling commenced _____
Drilling completed _____
Date Shot _____ From _____ To _____
With _____
Open Flow _____ /10ths Water in _____ Inch
_____ /10ths Merc. in _____ Inch
Volume _____ Cu. Ft.
Rock Pressure _____ lbs. _____ hrs.
Oil _____ bbls., 1st 24 hrs.
Fresh water _____ feet _____ feet
Salt water _____ feet _____ feet

Casing and Tubing	Used in Drilling	Left in Well	Packers
Size			Kind of Packer
16			
13			
10			Size of
8 1/4			
6 5/8	1380	1380	Depth set
5 3/16	1740	1740	
3			Perf. top
2			Perf. bottom
Liners Used			Perf. top
			Perf. bottom

CASING CEMENTED _____ SIZE _____ No. Ft. _____ Date _____

COAL WAS ENCOUNTERED AT _____ FEET _____ INCHES
_____ FEET _____ INCHES _____ FEET _____ INCHES
_____ FEET _____ INCHES _____ FEET _____ INCHES

Formation	Color	Hard or Soft	Top	Bottom	Oil, Gas or Water	Depth Found	Remarks
Big Dunkard			1000	1050			
First Salt			1255	1285			
Second Salt			1315	1365			
Water			1520				
Maxon			1628	1685			
Little Lime			1695	1708			
Big Lime			1751	1819			
Injun			1819	1870			
Total Depth				1872			
Oil and Gas			1828	1840			

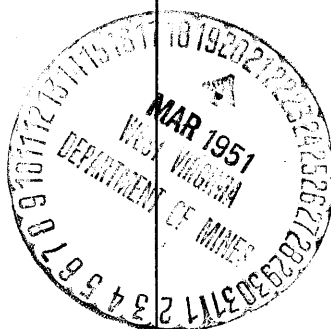

(Over)
JUN 28 1951

Central District, Deddridge County, W. Va.
 By Valley Steel Products Co., St. Louis, Mo.
 Abandoned under permit Ded-.....-A?

On 1 acre.

Elevation, 844' L.

Date of completion, etc., not given.

6⁵/₈" casing, 1330'; 5³/₁₆"², 1740'; all left in.

Oil well. Record to Dept. of Mines stamped March 20, 1951.

Record to RCT from Mrs. Griffith June 28, 1951. Old File No. 763.

	Top.	Bottom.
Big Dunkard Sand	1000	- 1060
First Salt Sand	1255	- 1285
Second Salt Sand (water, 1320')	1315	- 1365
Maxton Sand	1628	- 1685
Little Lime	1695	- 1708
Big Lime	1731	- 1819
Big Injun Sand (oil and gas, 1828- 1840')	1819	- 1870
Total depth		1872