

New Location   
 Drill Deeper   
 Abandonment

FEB 18 1952

Survey & Plat A.K. Westfall

Company Broadwater, Welch & Travis  
 Address Pennsboro, W.Va.  
 Farm Loyd McIntyre  
 Tract \_\_\_\_\_ Acres 99 Lease No. \_\_\_\_\_  
 Well (Farm) No. 1 Serial No. \_\_\_\_\_  
 Elevation (Spirit Level) 779  
 Quadrangle Centerpoint WC  
 County Doddridge District McClellan  
 Engineer B. Finckert  
 Engineer's Registration No. 648  
 File No. \_\_\_\_\_ Drawing No. \_\_\_\_\_  
 Date Dec 3, 1948 Scale 1" = 30 Poles

STATE OF WEST VIRGINIA  
 DEPARTMENT OF MINES  
 OIL AND GAS DIVISION  
 CHARLESTON

WELL LOCATION MAP  
 FILE NO. DOD-869-A

+ Denotes location of well on United States Topographic Maps, scale 1 to 62,500, latitude and longitude lines being represented by border lines as shown.

- Denotes one inch spaces on border line of original tracing.



767

STATE OF WEST VIRGINIA  
DEPARTMENT OF MINES  
OIL AND GAS DIVISION

WELL RECORD

Permit No. 080-869-A


Oil or Gas Well \_\_\_\_\_ (KIND)

Company Broadwater, Welch, & Travis  
 Address West Union, or Pennsboro, W. Va.  
 Farm Loyd McIntyre Acres 99  
 Location (waters) McElroy Creek  
 Well No. 1 Elev. 779  
 District McClellan County Dodd  
 The surface of tract is owned in fee by Loyd McIntyre  
West Union, W. Va. address  
 Mineral rights are owned by Loyd McIntyre  
West Union, W. Va. address  
 Drilling commenced no record  
 Drilling completed " "  
 Date Shot 6-11-25 From 1918 To 30 feet  
 With 6-24-29 1916 50 "  
 Open Flow /10ths Water in \_\_\_\_\_ Inch  
 \_\_\_\_\_ /10ths Merc. in \_\_\_\_\_ Inch  
 Volume \_\_\_\_\_ Cu. Ft.  
 Rock Pressure \_\_\_\_\_ lbs. \_\_\_\_\_ hrs.  
 Oil \_\_\_\_\_ bbls., 1st 24 hrs.  
 Fresh water \_\_\_\_\_ feet \_\_\_\_\_ feet  
 Salt water \_\_\_\_\_ feet \_\_\_\_\_ feet

Casing and Tubing	Used in Drilling	Left in Well	Packers
Size			Kind of Packer
16			
13	31	31	
10	307	307	Size of
8 1/4	990	pulled	
6 5/8	1746	1746	Depth set
5 3/16			
3			Perf. top
2	1934	1934	Perf. bottom
Liners Used			Perf. top
			Perf. bottom

CASING CEMENTED \_\_\_\_\_ SIZE \_\_\_\_\_ No. Ft. \_\_\_\_\_ Date \_\_\_\_\_  
 COAL WAS ENCOUNTERED AT 470 FEET \_\_\_\_\_ INCHES  
 \_\_\_\_\_ FEET \_\_\_\_\_ INCHES FEET \_\_\_\_\_ INCHES  
 \_\_\_\_\_ FEET \_\_\_\_\_ INCHES FEET \_\_\_\_\_ INCHES

Formation	Color	Hard or Soft	Top	Bottom	Oil, Gas or Water	Depth Found	Remarks
<u>Coal</u>			<u>476</u>				
<u>Maxon</u>			<u>1585</u>	<u>1640</u>			
<u>Big Ingun</u>			<u>1826</u>				
<u>Oil</u>			<u>1917</u>				
<u>Gas</u>			<u>1860</u>				
<u>Total Depth</u>			<u>1937</u>				

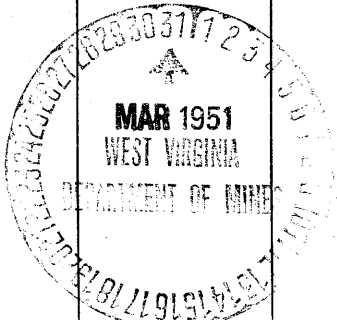

Formation	Color	Hard or Soft	Top	Bottom	Oil, Gas or Water	Depth Found	Remarks

Date \_\_\_\_\_, 19\_\_\_\_\_

**JAN. 5, 1949.**

APPROVED \_\_\_\_\_, Owner

**Broadwater, Welch, & Travis**

By **C. O. Travis** (partner)

LOYD McINTYRE NO. 1 WELL.

869A

McClellan District, Doddridge County, W. Va.  
 By Broadwater, Welch & Travis, West Union or Pennsboro, W. Va.  
 Abandoned under permit Dod-.....-A?  
 On 99 acres, on McElroy Creek.  
 Elevation, 779' L.  
 Surface and minerals owned by Loyd McIntyre, West Union, W. Va.  
 No record of date of completion, etc.  
 Shot June 11, 1925, at 1918', with 30 qts.; June 24, 1929, at 1916',  
 with 50 qts.  
 13" casing, 31'; 10", 307'; 8 1/4", 990' (pulled); 6 5/8", 1746'; 2" tubing,  
 1934'.  
 Coal was encountered at 470'.  
 Oil well. Record to Dept. of Mines dated Jan. 5, 1949; stamped  
 March 31, 1951.  
 Record to RCT from Mrs. Griffith Aug. 17, 1951. Old File No. 767.

	Top.	Bottom.
Coal	470	- ...
Maxton Sand	1535	- 1640
Big Injun Sand (gas, 1860'; oil, 1917')	1846	- ....
Total depth		1937