

New Location
 Drill Deeper
 Abandonment

FEB 18 1952

Company MURPHY OIL CO of PENNA.
 Address WEST UNION, W. VA.
 Farm W. L. ROLLINS
 Tract _____ Acres 75 Lease No. _____
 Well (Farm) No. 2, 5, 7 Serial No. _____
 Elevation (Spirit Level) 1180 - 993.7 - 896
 Quadrangle WEST UNION
 County DODDRIDGE District WEST UNION
 Engineer B. F. RINEHART
 Engineer's Registration No. 648
 File No. _____ Drawing No. 782-WD
 Date Sept. 21, 1950 Scale 1 in. = 400 ft.

STATE OF WEST VIRGINIA
 DEPARTMENT OF MINES
 OIL AND GAS DIVISION
 CHARLESTON

WELL LOCATION MAP
 DOD-887-A-#7
 FILE NO. DOD-891-A-#2
 * DOD-892-A-#5

+ Denotes location of well on United States Topographic Maps, scale 1 to 62,500, latitude and longitude lines being represented by border lines as shown.

- Denotes one inch spaces on border line of original tracing.

W.L. ROLLINS MS. 7, 2, & 5 - MURPHY OIL CO. OF PA., - DOD-887-A (#7)
 ID-891-892-A



STATE OF WEST VIRGINIA
DEPARTMENT OF MINES
OIL AND GAS DIVISION

787

WELL RECORD

Permit No. 000-892-A


Oil or Gas Well Oil & Gas
(KIND)

Company Murphy Oil Company of Penna.
Address West Union, West Virginia.
Farm W.L. Rollins Acres 75
Location (waters) Arnolds Creek
Well No. 5 Elev. 993.7
District West Union County Doddridge
The surface of tract is owned in fee by W.L. Rollins Address West Union, W. Va.
Mineral rights are owned by W.L. Rollins Address West Union, W. Va.
Drilling commenced _____
Drilling completed _____
Date Shot _____ From _____ To _____
With _____
Open Flow _____ /10ths Water in _____ Inch
_____ /10ths Merc. in _____ Inch
Volume _____ Cu. Ft.
Rock Pressure _____ lbs. _____ hrs.
Oil _____ bbls., 1st 24 hrs.
Fresh water _____ feet _____ feet
Salt water _____ feet _____ feet


Casing and Tubing	Used in Drilling	Left in Well	Packers
Size			Kind of Packer
16			
13			
10	408'	None	Size of
8 1/2	988'	"	
6 3/4	1839'	1839'	Depth set
5 3/16			
3			Perf. top
2	1918'	1918'	Perf. bottom
Liners Used			Perf. top
			Perf. bottom

CASING CEMENTED _____ SIZE _____ No. Ft. _____ Date _____
COAL WAS ENCOUNTERED AT 512 FEET _____ INCHES
_____ FEET _____ INCHES FEET _____ INCHES
_____ FEET _____ INCHES FEET _____ INCHES

Formation	Color	Hard or Soft	Top	Bottom	Oil, Gas or Water	Depth Found	Remarks
Hurry up Sand			352	404			
Pittsburgh Coal			512	514			
Little Dunkard			920	960			
Big Dunkard			980	1043			
Gas Sand			1155	1255			
1st. Salt Sand			1300	1370			
2nd. Salt Sand			1471	1492			
3rd. Salt Sand			1500	1588			
Maxon			1682	1732			
Little Lime			1774	1788			
Blue Monday			1790	1821			
Show of Oil			1820				
Pencil Cave			1821	1829			
Big Lime			1829	1898			
Top of Injun			1898				
Gas			1899	1903			
Oil			1904	1914			
Total Depth.			1920				

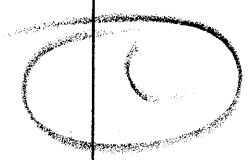

10-26-51
1918 0'
1025' 814'

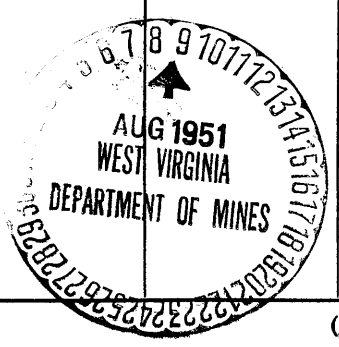

JAN 16 1952

W. L. ROLLINS NO. 5 WELL.

West Union District, Doddridge County, W. Va.
By Murphy Oil Co. of Penna., West Union, W. Va.
Abandoned under permit Ded-.....-A?
On 75 acres, on Arnolds Creek.
Elevation, ' L.

Surface and minerals owned by W. L. Rollins, West Union, W. Va.
Date of completion, etc., not given.
10" casing, 403' (pulled); 8 1/4", 988' (pulled); 6 3/8", 1839';
2" tubing, 1918'.

Coal was encountered at 512-514'.
Plugging record: Completed 10-26-51 (e-11-16-51). 2" tubing,
pulled 1918', lost 0'; 6 3/8", pulled 1025', lost 814'.
Oil and gas well. Record to Dept. of Mines dated Aug. 5, 1951.
Record to RCT from Mrs. Griffith Jan. 16, 1952. Old File No. 787.

	Top.	Bottom.
Hurry-up Sand	352	- 404
Pittsburgh Coal	512	- 514
Little Dunkard Sand	920	- 960
Big Dunkard Sand	980	- 1043
Gas Sand	1155	- 1255
1st Salt Sand	1300	- 1370
2nd Salt Sand	1471	- 1492
3rd Salt Sand	1500	- 1588
Maxton Sand	1682	- 1732
Little Lime	1774	- 1788
Blue Monday Sand (show of oil, 1820')	1790	- 1821
Pencil Cave	1821	- 1829
Big Lime	1829	- 1898
Big Injan Sand (gas, 1899-1903'; oil, 1904-1914')	1898	-
Total depth		1920