

Surface of the above tract is now owned by Opie D. Heflin, whose post office address is West Union, West Va. No coal development in this locality. Any coal underlying this surface is owned by the owner of the surface. Reference :- Deed from O.G. Talbott, et als. to Opie D. Heflin, dated December 18, 1943, and recorded in the Office of the Clerk of the County Court of Doddridge County, in Deed Book No. 105, at page 474.

Company L. L. SHINN  
 Address West Union, West Va.  
 Farm Knight Heirs  
 Tract Acres 23.8 Lease No. \_\_\_\_\_  
 Well (Farm) No. One Serial No. \_\_\_\_\_  
 Elevation (Spirit Level) 875  
 Quadrangle West Union  
 County Doddridge District West Union  
 Engineer [Signature]  
 Engineer's Registration No. 1227  
 File No. \_\_\_\_\_ Drawing No. \_\_\_\_\_  
 Date July 1951 Scale 1" = 300'

STATE OF WEST VIRGINIA  
 DEPARTMENT OF MINES  
 OIL AND GAS DIVISION  
 CHARLESTON

WELL LOCATION MAP  
 FILE NO. DOD-896-A

+ Denotes location of well on United States Topographic Maps, scale 1 to 62,500, latitude and longitude lines being represented by border lines as shown.

- Denotes one inch spaces on border line of original tracing.

KNIGHT HEIRS NO. 1 L. L. SHINN - DOD-896-A



8576

STATE OF WEST VIRGINIA  
DEPARTMENT OF MINES  
OIL AND GAS DIVISION

WELL RECORD

Oil or Gas Well **Oil**  
(KIND)

Permit No. Ab 846-A


Company L. L. Shinn - C. O. Travis  
 Address West Union, W. Va.  
 Farm Knight Hrs. Acres 23.3  
 Location (waters) to Doe Run  
 Well No. 1 Elev 875  
 District West Union, County Doddridge  
Opie D. Hefflin  
 The surface of tract is owned in fee by  
West Union, W. Va. Address \_\_\_\_\_  
 Mineral rights are owned by \_\_\_\_\_  
 Address \_\_\_\_\_  
 Drilling commenced Oct. 1925  
 Drilling completed Nov. 1925  
 Date Shot \_\_\_\_\_ From \_\_\_\_\_ To \_\_\_\_\_  
 With \_\_\_\_\_  
 Open Flow \_\_\_\_\_ /10ths Water in \_\_\_\_\_ Inch  
 \_\_\_\_\_ /10ths Merc. in \_\_\_\_\_ Inch  
 Volume \_\_\_\_\_ Cu. Ft.  
 Rock Pressure \_\_\_\_\_ lbs. \_\_\_\_\_ hrs.  
 Oil \_\_\_\_\_ bbls., 1st 24 hrs.  
 Fresh water \_\_\_\_\_ feet \_\_\_\_\_ feet  
 Salt water \_\_\_\_\_ feet \_\_\_\_\_ feet

Casing and Tubing	Used in Drilling	Left in Well	Packers
Size			
16			Kind of Packer
13			
10	355	none	Size of
8 1/4	935	none	
6 5/8	1722	1722	Depth set
5 3/16			
3			Perf. top
2			Perf. bottom
Liners Used			Perf. top
			Perf. bottom

CASING CEMENTED \_\_\_\_\_ SIZE \_\_\_\_\_ No. Ft. \_\_\_\_\_ Date \_\_\_\_\_  
 COAL WAS ENCOUNTERED AT 396 FEET \_\_\_\_\_ INCHES  
 \_\_\_\_\_ FEET \_\_\_\_\_ INCHES FEET \_\_\_\_\_ INCHES  
 \_\_\_\_\_ FEET \_\_\_\_\_ INCHES FEET \_\_\_\_\_ INCHES

Formation	Color	Hard or Soft	Top	Bottom	Oil, Gas or Water	Depth Found	Remarks
<del>Coal</del>			596				
B. Dunkard			935	947			
Salt sand			1080	1120			
Salt sand			1140	1300			
B. Lime			1720	1795			
B. Ingun			1795	1872			
Gordon Sand			2451	2460			
Total Depth				2482	Oil & Gas	2452	

O.F. 827

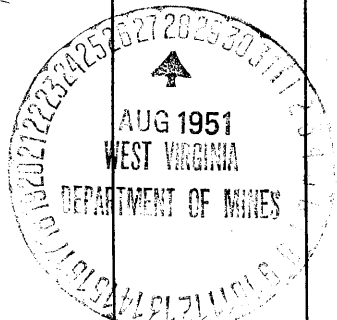

MAY 21 1952 (Over)

Formation	Color	Hard or Soft	Top	Bottom	Oil, Gas or Water	Depth Found	Remarks

Date Aug 27, 1957

APPROVED B. O. Travis, Owner

By \_\_\_\_\_

(Title)