

Latitude 39° 15'

Longitude 80° 45'



F. LEGGETT

High ridge road
stone stone

NO. 1
ELEV. 1125'

NO. 23

MARY J. MINEAR
5.2 ACRES

NO. 2

LAURA HANSFORD

SARA NICHOLSON


N. 1° E. 1401'

S. 6° W. 1485'

stone N 72° 30' W. 107' stone

H. SMITH

drain

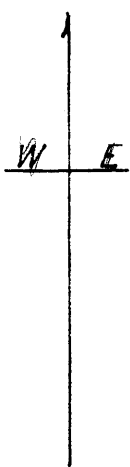

- New Location
- Drill Deeper
- Abandonment

FEB 18 1952

4.37 W
0.57 A

Company DEPUY BROTHERS
 Address WEST UNION, W. VA.
 Farm MARY J. MINEAR
 Tract _____ Acres 5.2 Lease No. _____
 Well (Farm) No. 1 Serial No. _____
 Elevation (Spirit Level) 1125'
 Quadrangle HOLBROOK
 County DODDRIDGE District WEST UNION
 Engineer George R. Clarke
 Surveyed by Homer W. Myers
 Engineer's Registration No. 102
 File No. _____ Drawing No. _____
 Date OCT. 2 1951 Scale 1" = 200'

STATE OF WEST VIRGINIA
DEPARTMENT OF MINES
OIL AND GAS DIVISION
CHARLESTON

WELL LOCATION MAP
FILE NO. DOD-897A

+ Denotes location of well on United States Topographic Maps, scale 1 to 62,500, latitude and longitude lines being represented by border lines as shown.

- Denotes one inch spaces on border line of original tracing.

"IMPERIAL" TRACING CLOTH
K & E CO., N. Y.

MARY J. MINEAR No. 1 — DEPUY BROS. —

DOD-897-A



STATE OF WEST VIRGINIA
DEPARTMENT OF MINES
OIL AND GAS DIVISION

846

WELL RECORD

Permit No. 000-897-A

Oil or Gas Well gas
(KIND)

Company DePuy Brothers (Droplemen)
Address Box 285, West Union, W. Va.
Farm Mary J. Minear Acres _____
Location (waters) _____
Well No. 1 Elev. 1125
District West Union County Doddridge
The surface of tract is owned in fee by Mary J. Minear
Address West Union, W. Va.
Mineral rights are owned by same party
Address _____
Drilling commenced No record (after 1929)
Drilling completed no record available
Date Shot none From _____ To _____
With _____
Open Flow _____ /10ths Water in _____ Inch
_____ /10ths Merc. in _____ Inch
Volume no record Cu. Ft.
Rock Pressure no record lbs. _____ hrs.
Oil none bbls., 1st 24 hrs.
Fresh water _____ feet _____ feet
Salt water 1650' feet _____ feet

| Casing and Tubing | Used in Drilling | Left in Well | Packers |
|-------------------|------------------|--------------|----------------------|
| Size | | | |
| 16 | 16' | 16' | Kind of Packer _____ |
| 13 | | | |
| 10 | 635' | 635' | Size of _____ |
| 8 1/4 | 1265' | 1265' | |
| 6 1/2 | 1610' | 1610' | Depth set _____ |
| 5 3/16 | | | |
| 3 | | | Perf. top _____ |
| 2 | | 2125' | Perf. bottom _____ |
| Liners Used | | | Perf. top _____ |
| | | | Perf. bottom _____ |

CASING CEMENTED _____ SIZE _____ No. Ft. _____ Date _____
COAL WAS ENCOUNTERED AT _____ FEET _____ INCHES
_____ FEET _____ INCHES FEET _____ INCHES
_____ FEET _____ INCHES FEET _____ INCHES

| Formation | Color | Hard or Soft | Top | Bottom | Oil, Gas or Water | Depth Found | Remarks |
|-------------|-------|--------------|-------|--------|-------------------|-------------|------------|
| Coal | | soft | 460' | 462' | | | Pittsburgh |
| sand | | | 995' | 1055' | | | L. Dunkard |
| sand | | | 1210' | 1235' | | | B. Dunkard |
| sand | | | 1280' | 1328' | | | Gas Sand |
| sand | | | 1410' | 1468' | | | 1st. Salt |
| sand | | | 1540' | 1655' | | | 2nd. Salt |
| sand | | | 1700' | 1760' | | | 3rd Salt |
| sand | | | 1940' | 1943' | | | Maxton |
| lime | | | 1990' | 2010' | | | L. Lime |
| sand | | | 2010' | 2026' | | | B. Monday |
| lime | | | 2026' | 2087' | | | Big Lime |
| sand | | | 2087' | 2135' | Gas | 2097' | Injun |
| total depth | | | 2150' | | | | |



(Over)
FEB 29 1952

| Formation | Color | Hard or Soft | Top | Bottom | Oil, Gas or Water | Depth Found | Remarks |
|-----------|-------|--------------|-----|--------|-------------------|-------------|---------|
| | | | | | | | |

Date SEP 8 - 1951, 19

APPROVED _____, Owner

By Geo DePuy, Partner
(Title)

MARY J. MINEAR NO. 1 WELL.

West Union District, Doddridge County, W. Va.
 By DePuy Brothers (Droppleman), Box 285, West Union, W. Va.
 Abandoned underpermit Dod-.....-A?
 On.....acres.

Dodd 897A

Elevation,' L.
 Surface and minerals owned by Mary J. Minear, West Union, W. Va.
 No record available of date of completion (after 1929).
 Well was not shot.

No record of gas volume.
 Salt water at 1650'.
 16" conductor, 16'; 10" casing, 635'; 8 1/2", 1265'; 6 3/8", 1610'; 2" tubing,
 2125'.

Gas well. Record to Dept. of Mines dated Sept. 8, 1951.
 Record to RCT from Mrs. Griffith Feb. 29, 1952. Old File No. 846.

| | Top. | Bottom. |
|-----------------------------|------|---------|
| Pittsburgh Coal, soft | 460 | - 462 |
| Little Dunkard Sand | 995 | - 1055 |
| Big Dunkard Sand | 1210 | - 1235 |
| Gas Sand | 1280 | - 1328 |
| 1st Salt Sand | 1410 | - 1468 |
| 2nd Salt Sand | 1540 | - 1655 |
| 3rd Salt Sand | 1700 | - 1760 |
| Marion Sand | 1987 | - 1943 |
| Little Lime | 1990 | - 2010 |
| Blue Monday Sand | 2010 | - 2026 |
| Big Lime | 2026 | - 2087 |
| Big Injun Sand (gas, 2097') | 2087 | - 2135 |
| Total depth | | 2150 |