

7.43 W  
7.84 Q

Surface owned by Connie V. Dye.  
Address: Mrs. Connie V. Dye, 94. Pennsylvania Ave. Salem, W. Va.  
Coal owned by Willis G. Tetrick, Jr. et al.  
Address: Mr. Willis G. Tetrick, Jr. P.O. Box No. 267. Clarksburg, W. Va.

New Location   
Drill Deeper   
Abandonment

FEB 18 1952

On 800' Map N39, Sqs. S 5 E 4.

Company	Road Supply Co.
Address	Salem, W. Va.
Farm	Felix R. Coffman
Tract	Acres 108 4/5 Lease No.
Well (Farm) No.	4 Serial No.
Elevation (Spirit Level)	Floor - 1156.37 Ground - 1155.37
Quadrangle	Centerpoint
County	Doddridge District McClellan
Engineer	Elsworth Haines
Engineer's Registration No.	2221.
File No.	Drawing No.
Date	July 2nd, 1951. Scale 1" = 800 Feet

STATE OF WEST VIRGINIA  
DEPARTMENT OF MINES  
OIL AND GAS DIVISION  
CHARLESTON

**WELL LOCATION MAP**  
FILE NO. DOD - 899-A

+ Denotes location of well on United States Topographic Maps, scale 1 to 62,500, latitude and longitude lines being represented by border lines as shown.

- Denotes one inch spaces on border line of original tracing.



863

STATE OF WEST VIRGINIA  
DEPARTMENT OF MINES  
OIL AND GAS DIVISION

WELL RECORD

Permit No. 000-899-A

Oil or Gas Well \_\_\_\_\_ (KIND)


Company Raad Supply Company  
 Address 184 East Main St., Salem, W. Va.  
 Farm Felix R. Coffman Acres 108 4/5  
 Location (waters) Left prong of Skeleton Run.  
 Well No. 4 Elev. 1155.37  
 District Doddridge County McClelland  
 The surface of tract is owned in fee by Mrs. Connie V. Dye  
94 Pennsylvania Ave. Address Salem, W. Va.  
 Mineral rights are owned by Willis G. Tetrick, Jr.  
Box 267 Address Clarksburg, W. Va.  
 Drilling commenced No record  
 Drilling completed No record  
 Date Shot From \_\_\_\_\_ To \_\_\_\_\_  
 With \_\_\_\_\_  
 Open Flow /10ths Water in \_\_\_\_\_ Inch  
 /10ths Merc. in \_\_\_\_\_ Inch  
 Volume \_\_\_\_\_ Cu. Ft.  
 Rock Pressure \_\_\_\_\_ lbs. \_\_\_\_\_ hrs.  
 Oil \_\_\_\_\_ bbls., 1st 24 hrs.  
 Fresh water \_\_\_\_\_ feet \_\_\_\_\_ feet  
 Salt water \_\_\_\_\_ feet \_\_\_\_\_ feet

Casing and Tubing	Used in Drilling	Left in Well	Packers
Size			
16			Kind of Packer
13			
	<u>278'</u>	<u>None</u>	Size of
8 1/4	<u>1378'</u>	<u>None</u>	
6 5/8	<u>2180'</u>	<u>2180'</u>	Depth set
5 3/16	<u>2925'</u>	<u>2230'</u>	
3			Perf. top
2	<u>3052'</u>	<u>3052'</u>	Perf. bottom
Liners Used			Perf. top
			Perf. bottom

CASING CEMENTED No SIZE \_\_\_\_\_ No. Ft. \_\_\_\_\_ Date \_\_\_\_\_

COAL WAS ENCOUNTERED AT 917 FEET 24 INCHES  
 FEET INCHES FEET INCHES  
 FEET INCHES FEET INCHES

Formation	Color	Hard or Soft	Top	Bottom	Oil, Gas or Water	Depth Found	Remarks
<b>Pittsburgh Coal</b>			<b>915</b>	<b>917</b>			
<b>Little Dunkard</b>			<b>1050</b>	<b>1095</b>			
<b>Big Dunkard</b>			<b>1375</b>	<b>1400</b>			
<b>Big Lime</b>			<b>2160</b>	<b>2215</b>			
<b>Injun Sand</b>			<b>2215</b>	<b>2345</b>			
<b>Thirty Foot</b>			<b>2920</b>	<b>2943</b>			
<b>Gordon Stray</b>			<b>2964</b>	<b>3013</b>			
<b>Gordon Sand</b>			<b>3031</b>	<b>3052</b>			
<b>Total Depth</b>				<b>3052</b>			

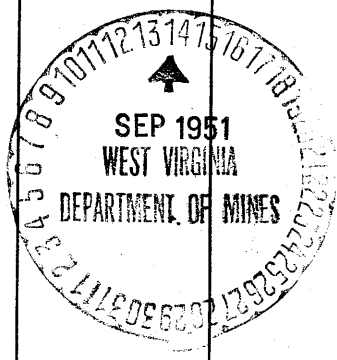



FELIX R. COFFMAN NO. 4 WELL.

899A

Madison McClellan District, Doddridge County, W. Va.  
 By Road Supply Co., 184 E. Main St., Salem, W. Va.  
 Abandoned under permit Dod-.....-A?  
 On 108-4/5 acres, on left prong of Skeleton Run.  
 Elevation, 1155.37' L.

Surface owned by Mrs. Connie V. Dye, 92 Pennsylvania Ave., Salem, W. Va.,  
 and minerals by Willis G. Tetrick, Jr., Box 267, Clarksburg, W. Va.  
 No record of date of completion, etc.  
 10" casing, 278' (pulled); 8 1/4", 1378' (pulled); 6 3/8", 2180'; 5 1/8", 2925';  
 2" tubing, 3052'.

Coal was encountered at 915-917'.  
 .....? well. Record to Dept. of Mines dated Sept. 12, 1951.  
 Record to RCT from Mrs. Griffith July 9, 1952. O.F.No.863.

	Top.	Bottom.
Pittsburgh Coal	915	- 917
Little Dunkard Sand	1050	- 1095
Big Dunkard Sand	1375	- 1400
Big Lime	2160	- 2215
Big Injun Sand	2215	- 2345
Thirty-foot Sand	2920	- 2943
Gordon Stray Sand	2964	- 3013
Gordon Sand	3031	- 3052
Total depth		3052