

Latitude 39°25'00"

11,00,014.00

Longitude

+ 25'

Topo Location

7.5' Loc.	<u>1.00S</u>	15' Loc.	<u>1.00S</u>
	<u>1.54W</u>	(calc.)	<u>1.54W</u>

Company \_\_\_\_\_

Farm Nancy Underwood #9

15' Quad Center Point W2  
(sec.)

7.5' Quad Center Point

District McClellan

WELL LOCATION PLAT

County 017 Permit 30917

WELL RECORD


Oil or Gas Well (1911)

Company Wartz Bros.  
 Address P.O. Mail to Ore Boss Ashland, W. Va.  
 Farm Zedoc Underwood  
 Location (nearest) \_\_\_\_\_  
 Well No. 1110 Elev. \_\_\_\_\_  
 District No. 11 County Doddridge  
 The surface of tract is owned in fee by \_\_\_\_\_  
 Address \_\_\_\_\_  
 Mineral rights are owned by \_\_\_\_\_  
 Address \_\_\_\_\_  
 Drilling commenced \_\_\_\_\_  
 Drilling completed Nov. 1930  
 Date shut \_\_\_\_\_ From \_\_\_\_\_ To \_\_\_\_\_  
 With \_\_\_\_\_  
 Open Flow \_\_\_\_\_ /10ths Water in \_\_\_\_\_ Inch  
 \_\_\_\_\_ /10ths Merc. in \_\_\_\_\_ Inch  
 Volume \_\_\_\_\_ Cu. Ft.  
 Rock Pressure \_\_\_\_\_ lbs. \_\_\_\_\_ hrs.  
 Oil \_\_\_\_\_ bbls. per 24 hrs.  
 Fresh water \_\_\_\_\_ feet \_\_\_\_\_ feet  
 Salt water \_\_\_\_\_ feet \_\_\_\_\_ feet

Casing and Tubing	Used in Drilling	Left in Well	Packers
16			Kind of Packor
18			
10		379	Size of
8 1/2		1257	
6 1/2		2059	Depth set
5 1/16			
2			Perf. top
2			Perf. bottom
2			Perf. top
			Perf. bottom

CASING CEMENTED \_\_\_\_\_ SIZE \_\_\_\_\_ No. Ft. \_\_\_\_\_ Date \_\_\_\_\_  
 COAL WAS ENCOUNTERED AT 808 FEET 12 INCHES  
 \_\_\_\_\_ FEET \_\_\_\_\_ INCHES \_\_\_\_\_ FEET \_\_\_\_\_ INCHES  
 \_\_\_\_\_ FEET \_\_\_\_\_ INCHES \_\_\_\_\_ FEET \_\_\_\_\_ INCHES


Formation	Color	Hard or Soft	Top	Bottom	Oil, Gas or Water	Depth Found	Remarks
Pyth Coal			808	809			
Marines			1920	1958			
Lima			2039	2167	oil 22 5/8		
Total Depth.				2260			

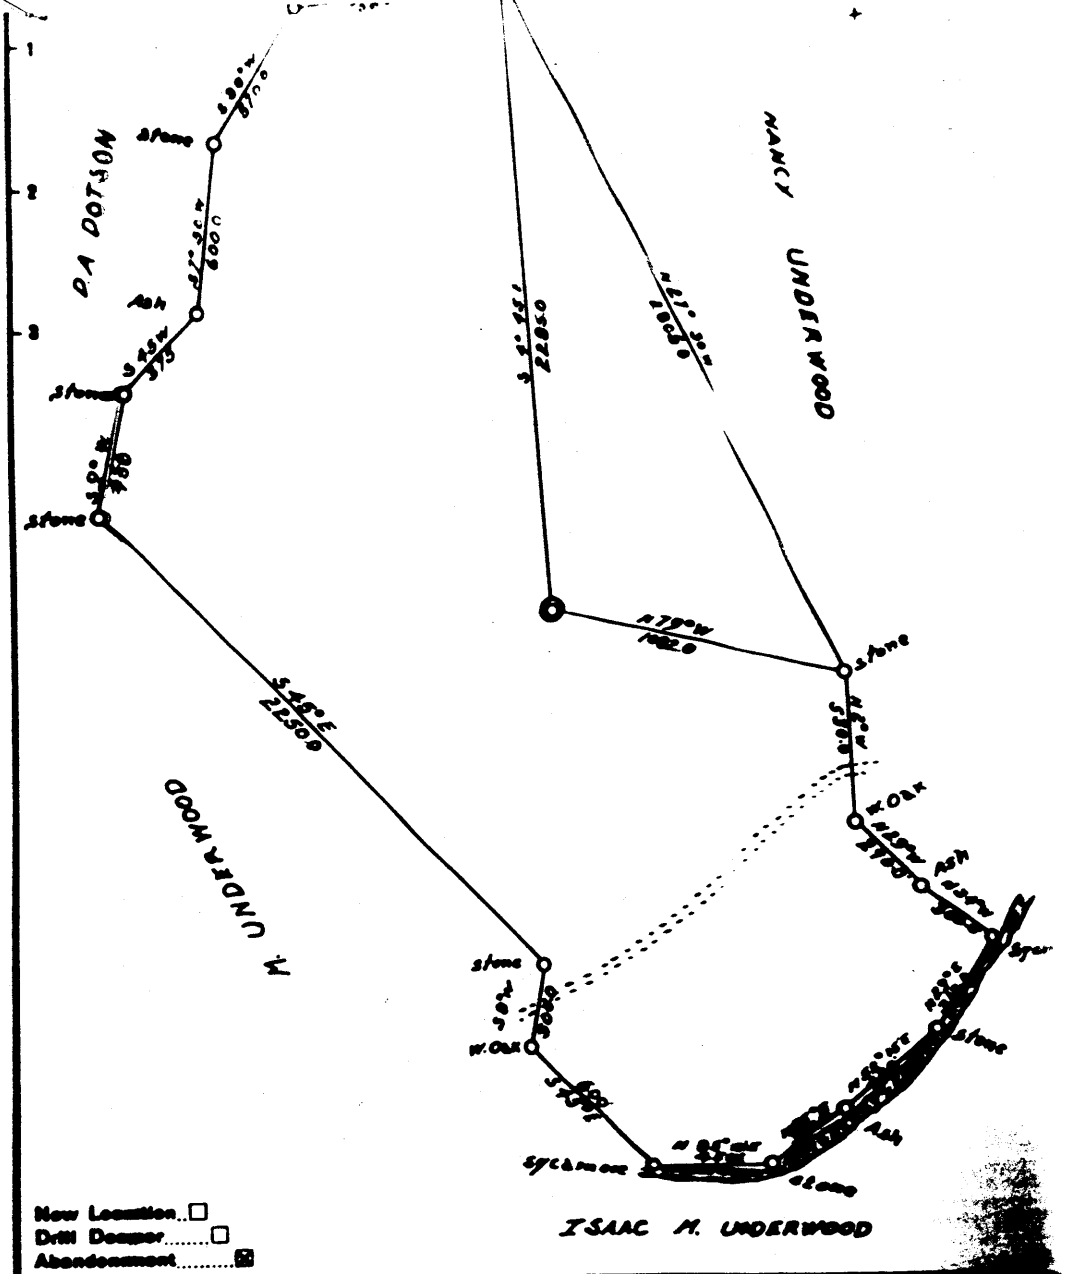

New Location   
 Drill Deeper   
 Abandonment

Company WARTZ BROTHERS  
 Address PITTSBURGH Pa.  
 Farm ZEDOC UNDERWOOD  
 Tract ONE Acres 161 Lease No. \_\_\_\_\_  
 Well (Farm) No. 9 Serial No. \_\_\_\_\_  
 Elevation (Spirit Level) 980  
 Quadrangle CENTERPOINT  
 County DODDRIDGE

STATE OF WEST VIRGINIA  
 DEPARTMENT OF MINES  
 OIL AND GAS DIVISION  
 CHARLESTON  
**WELL LOCATION MAP**  
 FILE NO. DDO-917-B  
 + Denotes location of well on United States

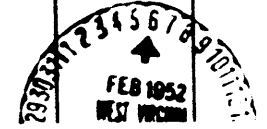

NOTICE OF INTENTION

To The Department of Mines

Call to Ora Seese,
Ashley, W. Va.

Jan. 20, 19 52

W. Va. State ABANDONED

McClellan District

Dodridge County

Well No. 9

Zedoc Underwood Farm

Gentlemen:

The undersigned well operator is about to abandon the above described well and will commence

Will notify inspector.

the work of plugging and abandoning said well on the day of 19 (which date shall not be less than five days after the day on which this notice is mailed is received, or in due course should be received by the Department of Mines.)

This notice is given you in order that your respective representative may be present at the plugging and filling of said well. You are further notified that whether you are represented or not represented the undersigned will proceed on that date, or shortly thereafter, to plug and fill said well in the manner required by Section 10, Article 4, Chapter 22 of the Code and given in detail on the reverse side of this notice in "Work Order."

This notice is being mailed by registered mail to each of you at the above addresses on the above date.

Very truly yours,

Ora Seese, Sgt.

Well Operator

FEB 1952 WEST VIRGINIA

NOTE: Upon the abandonment of a well...

WEST VIRGINIA DEPARTMENT OF MINES

OIL AND GAS DIVISION

WORK ORDER

Well to be plugged and filled as follows:

- Clay 2260 to 1900
Cement 1900 to 1800
Bridge & Cement to 1800
Clay 1870 to 1600
Cement 1600 to 1580
Bridge 1400 Stone & cement to 1380
Clay 1380 to 1287
Cement 1287 to 1277
Bridge 900 Stone & Cement to 880
Clay 880 to 450
Cement 450 to 440
Clay 440 to Surface.
erector marker.

in compliance with Rule 18, 1931 Regulations

To the Department of Mines
Coal Owner or Operator,
Lease or Property Owner.

Gentlemen:

This "work order" is submitted for your approval and concurrence and unless notified of your disapproval or non-concurrence, the undersigned will proceed with the plugging and filling of said well in the above described manner on the date stated in the notice of intention to plug and abandon the said well on opposite side of this sheet.

Very truly yours,

No objections have been filed by the coal owner or coal operator, or any available adjacent lease or property owners or interposed by the Department of Mines to the manner herein described for the plugging and filling of the well above mentioned. Therefore, the same is hereby approved this

6th day of February, 1952

DEPARTMENT OF MINES