

Latitude 39° 17' 30"

8852' 30"

Longitude

+ 251

Topo Location

7.5' Loc. 2.52S 15' Loc. 5.40S  
0.31W (calc.) 2.54W

Company \_\_\_\_\_

Farm W. F. Hudkins #2

15' Quad Wgt Union SC  
(sec.)

7.5' Quad Pennsboro

District Central

WELL LOCATION PLAT

County 017 Permit 30926

ELLIOTT

W. F. HUDKINS  
201 A.

No. 2 Elevation 981

HUFFORD

C.O.

Longitude 80°

New Location   
Drill Deeper   
Abandonment

Company	JAMES R. MOOREN	
Address	PENNSBORO, N.Y.A.	
Farm	W. F. HUDKINS	
Tract	Acres 801	Lease No. _____
Well (Farm) No.	2	Serial No. _____
Elevation (Spirit Level)	981	
Quadrangle	WEST UNION	
County	DODDRIDGE	District CENTRAL
Operator	B. F. BINEHART	

STATE OF WEST VIRGINIA  
DEPARTMENT OF MINES  
OIL AND GAS DIVISION  
CHARLESTON

WELL LOCATION  
FILE NO. DOD-981

◆ Denotes location of well on United States Topographic Maps, scale 1 to 62,500. Meridian and longitude lines being represented.

W.E. HUDKINS NO. 2 WELL.

926A

Central District, Doddridge County, W. Va.  
By J. R. Keoken, Pennsboro, W. Va.  
Abandoned under permit Dod-.....-A?  
On 201 acres, on Lesson Run.  
Elevation, 921' L.  
Drilling completed, approx. 1920.  
10" casing, 320' (pulled); 8 1/2", 1060' (pulled); 6 3/4", 1886'.  
Oil well. Record to Dept. of Mines dated June 2, 1952.  
Record to ROT from Mrs. Griffith Dec. 2, 1952. O.F.No.876.

	Top.	Bottom.
Little Dunkard Sand	1055	- 1080
Big Dunkard Sand	1090	- 1150
Lime, slate, and shells	1190	- 1440
Salt Sand	1440	- 1485
2nd Salt Sand	1575	- 1675
Marton Sand	1795	- 1815
Little Lime	1825	- 1840
Big Lime	1878	- 1967
Big Injun Sand	1967	- 2052
Total depth		2071



STATE OF WEST VIRGINIA  
DEPARTMENT OF MINES  
OIL AND GAS DIVISION

76

Permit No. 926 - A

WELL RECORD

Oil or Gas Well Oil  
(KIND)


Company J. R. Kooken  
Address Pennsboro, W. Va.  
Farm W. F. Hudkins Acres 201  
Location (waters) Leeson Run  
Well No. 2 Elev. 921  
District Central County Doddridge  
The surface of tract is owned in fee by W. F. Hudkin Heirs  
Address \_\_\_\_\_  
Mineral rights are owned by \_\_\_\_\_  
Address \_\_\_\_\_

Casing and Tubing	Used in Drilling	Left in Well	Packers
Size			Kind of Packer
16			
13			
10	320	-0-	Size of
8 1/4	1060	-0-	
6 5/8	1886	1886	Depth set
5 3/16			
3			Perf. top
2			Perf. bottom
Liners Used			Perf. top
			Perf. bottom

Drilling commenced \_\_\_\_\_  
Drilling completed Approx. 1920  
Date Shot \_\_\_\_\_ From \_\_\_\_\_ To \_\_\_\_\_  
With \_\_\_\_\_  
Open Flow \_\_\_\_\_ /10ths Water in \_\_\_\_\_ Inch  
\_\_\_\_\_ /10ths Merc. in \_\_\_\_\_ Inch  
Volume \_\_\_\_\_ Cu. Ft.  
Rock Pressure \_\_\_\_\_ lbs. \_\_\_\_\_ hrs.  
Oil \_\_\_\_\_ bbls., 1st 24 hrs.  
Fresh water \_\_\_\_\_ feet \_\_\_\_\_ feet  
Salt water \_\_\_\_\_ feet \_\_\_\_\_ feet

CASING CEMENTED	SIZE	No. Ft.	Date
COAL WAS ENCOUNTERED AT _____ FEET _____ INCHES			
	FEET	INCHES	FEET
	FEET	INCHES	FEET
	FEET	INCHES	FEET

Formation	Color	Hard or Soft	Top	Bottom	Oil, Gas or Water	Depth Found	Remarks
Little Dunkard			1055	1080			
Big Dunkard			1090	1150			
Line, Slate, & Shells			1190	1440			
Salt Sand			1440	1485			
2nd Salt Sand			1575	1675			
Maxon Sand			1795	1815			
Little Lime			1825	1840			
Big Lime			1878	1967			
Big Injun			1967	2052			
Total Depth				2071			

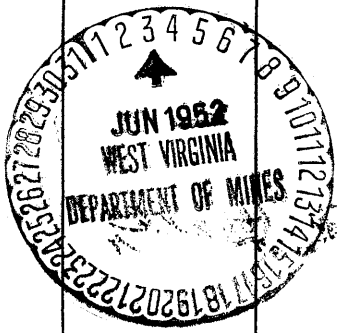

(Over)  
DEC 2 1952



**AFFIDAVIT OF PLUGGING AND FILLING WELL**

AFFIDAVIT SHOULD BE MADE IN TRIPPLICATE AND COPY SENT TO THE DEPARTMENT AND COPY TO BE RETURNED TO THE WELL OPERATOR AND THE TRUSTEES. (SEE SPECIAL ORDER IF REQUIRED). CHECKS BE MAILED TO EACH COPIE OPERATOR AT THEIR RESPECTIVE ADDRESSES.

Name J. K. Kooken  
 NAME OF WELL OPERATOR  
Pennsboro, N. Va.  
 ADDRESS  
 COMPLETE ADDRESS  
August 4 19 52  
 WELL AND LOCATION  
ventral District  
Doddridge County  
 Well No. 2 Farm Harry V. Mace  
 ADDRESS  
 COMPLETE ADDRESS

**STATE INSPECTOR SUPERVISING PLUGGING**

**AFFIDAVIT**

STATE OF WEST VIRGINIA, County of Putnam  
 I, J. R. Kooken and J. W. Sillifritt being first duly sworn according to law depose and say that they are experienced in the work of plugging and filling oil and gas wells and were employed by J. K. Kooken well operator, and participated in the work of plugging and filling the above well, that said work was commenced on the 16th day of June, 19 52, and that the well was plugged and filled in the following manner:

NAME OF WELL OPERATOR	ADDRESS	DATE	TO	PLUGGING MATERIAL	PLUGGING DEPTH	DATE	WELL NO.	WELL LOCATION	DISTRICT	COUNTY	FARM
Injun Hand	Red clay	2071	1916								
Big Jam	Best cement	1916	1906								
Maxon Sept	Gr. stone	1906	1901								
	clay	1901	1805		6-5/8"	700	1186				
	Best cement	1805	1795								
	Gr. stone	1795	1790								
2nd Salt Sand	Per. Bricks	1575									
	2 sls cement & 5' of stone										
	clay	1440									
	Best cement	1440	1430								
	Gr. stone	1430	1425								
	Per. Bricks	1060									
	2 sls cement & 5' of stone										
	clay	800									
	Best cement	800	790								
	Gr. stone	790	785								
	Per. Bricks	320									
	2 sls cement & 5' of stone				6-5/8"						
	clay	-0-									

and that the work of plugging and filling said well was completed on the 30th day of JUNE, 19 52  
 And further deponents swear so.  
 Sworn to and subscribed before me this 5th day of August, 19 52

STATE OF WEST VIRGINIA  
 DEPARTMENT OF MINES  
 OIL AND GAS DIVISION  
**INSPECTOR'S PLUGGING REPORT**  
 Permit No. \_\_\_\_\_ Well No. \_\_\_\_\_  
 COMPANY \_\_\_\_\_ ADDRESS \_\_\_\_\_  
 FARM \_\_\_\_\_ DISTRICT \_\_\_\_\_ COUNTY \_\_\_\_\_  
 Filling Material Used \_\_\_\_\_

Layer	Location	Amount	BRIDGES		Location	
			CONSTRUCTION-LOCATION	RECOVERED		
CEMENT-THICKNESS	WELL-DEPT	LEAD			SIZE	LOST
					6-5/8"	1186'

Drillers' Names \_\_\_\_\_  
 Remarks: \_\_\_\_\_  
 JUL 1952  
 HARRY V. MACE  
 Inspector  
 Harry V. Mace