

Latitude 39° 17' 30"

75'  
+

80° 42' 30"

Longitude

Topo Location

7.5' Loc. 0.66S 15' Loc. 3.54S  
1.40W (calc.) 3.63W

Company \_\_\_\_\_

Farm Susan Jones

15' Quad Outpost SW  
(sec.)

7.5' Quad Smithburg

District West Union

WELL LOCATION PLAT

County 017 Permit 30934

WELL RECORD

(1) or Gas Well


Permit No. \_\_\_\_\_

Company \_\_\_\_\_  
 Address \_\_\_\_\_  
 Farm \_\_\_\_\_  
 Location (waters) \_\_\_\_\_  
 Well No. \_\_\_\_\_  
 District \_\_\_\_\_  
 The surface of tract is owned in fee by \_\_\_\_\_  
 Mineral rights are owned by \_\_\_\_\_  
 Drilling commenced \_\_\_\_\_  
 Drilling completed \_\_\_\_\_  
 Date Shot \_\_\_\_\_  
 With \_\_\_\_\_  
 Open Flow \_\_\_\_\_  
 Volume \_\_\_\_\_  
 Back Pressure \_\_\_\_\_  
 Oil \_\_\_\_\_  
 Fresh water \_\_\_\_\_  
 Salt water \_\_\_\_\_

CASING CEMENTED \_\_\_\_\_  
 COAL WAS ENCOUNTERED AT \_\_\_\_\_  
 FEET \_\_\_\_\_ INCHES \_\_\_\_\_  
 FEET \_\_\_\_\_ INCHES \_\_\_\_\_  
 FEET \_\_\_\_\_ INCHES \_\_\_\_\_

Formation	Color	Hard or Soft	Top	Bottom	Oil, Gas or Water	Depth Feet	Remarks
No record of log							
No record of casing							
gas							
well top shot							
Total depth			2237'				Well apparently has string of 7" casing - do not know amount

Longitude 80° 40'

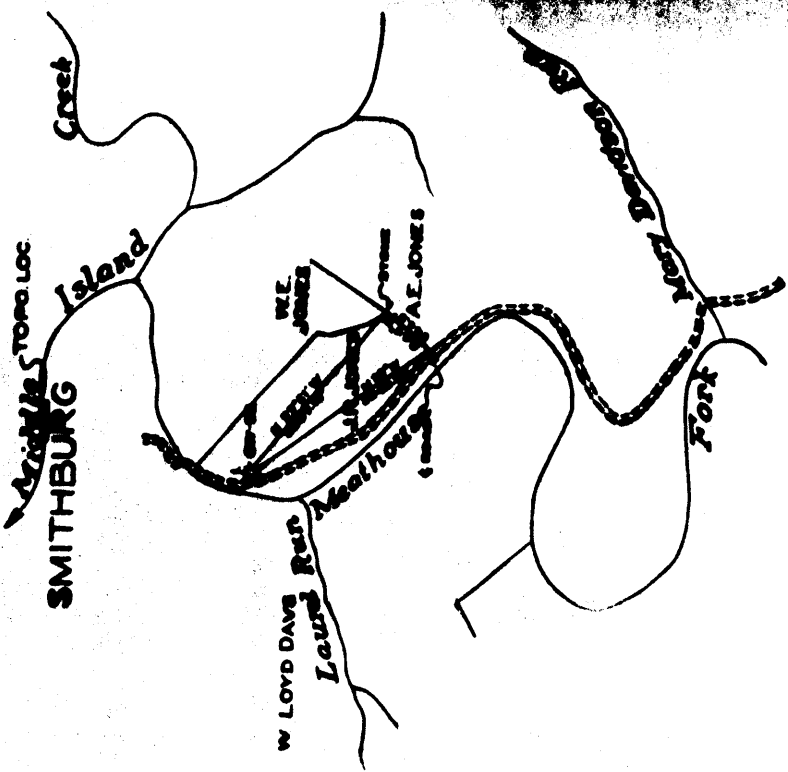

New Location   
 Drill Deeper   
 Abandonment

Company Columbian Carbon Co  
 Address Box 673 - Charleston, W. Va.  
 Farm J.R. Jones  
 Tract Acres 32 Lease No. C-33  
 Well (Farm) No. 1 Serial No. GW-92  
 Elevation (Spirit Level) 815'  
 Grids Centerpoint 93W E-10E

STATE OF WEST VIRGINIA  
 DEPARTMENT OF MINES  
 OIL AND GAS DIVISION  
 CHARLESTON  
 WELL LOCATION MAP  
 FILE NO. 000-9349

J. R. JONES NO. 1 (GW-92) WELL.

West Union District, Doddridge County, W. Va.  
By Columbian Carbon Co., Box 873, Charleston, 23, W. Va.  
Abandoned under permit Dod-.....-A?  
On 32 acres. *934-A*  
Elevation, 815' L.  
Date of completion not given.  
No record of log.  
No record of casing.  
Well not shot.  
Well apparently has string of 7" casing - do not know amount.  
Gas well. Record to Dept. of Mines stamped Sept. 26, 1952.  
Record to RCT from Mrs. Griffith Feb. 11, 1953. O.F.No.895.

<i>Japan</i>	<i>Godon</i>	Top.	Bottom.
Gas, <del>1584-1657</del> '	gas, 2236-2237'.		
Total depth			2237

