


Latitude 39° 15'

Longitude 80° 50'

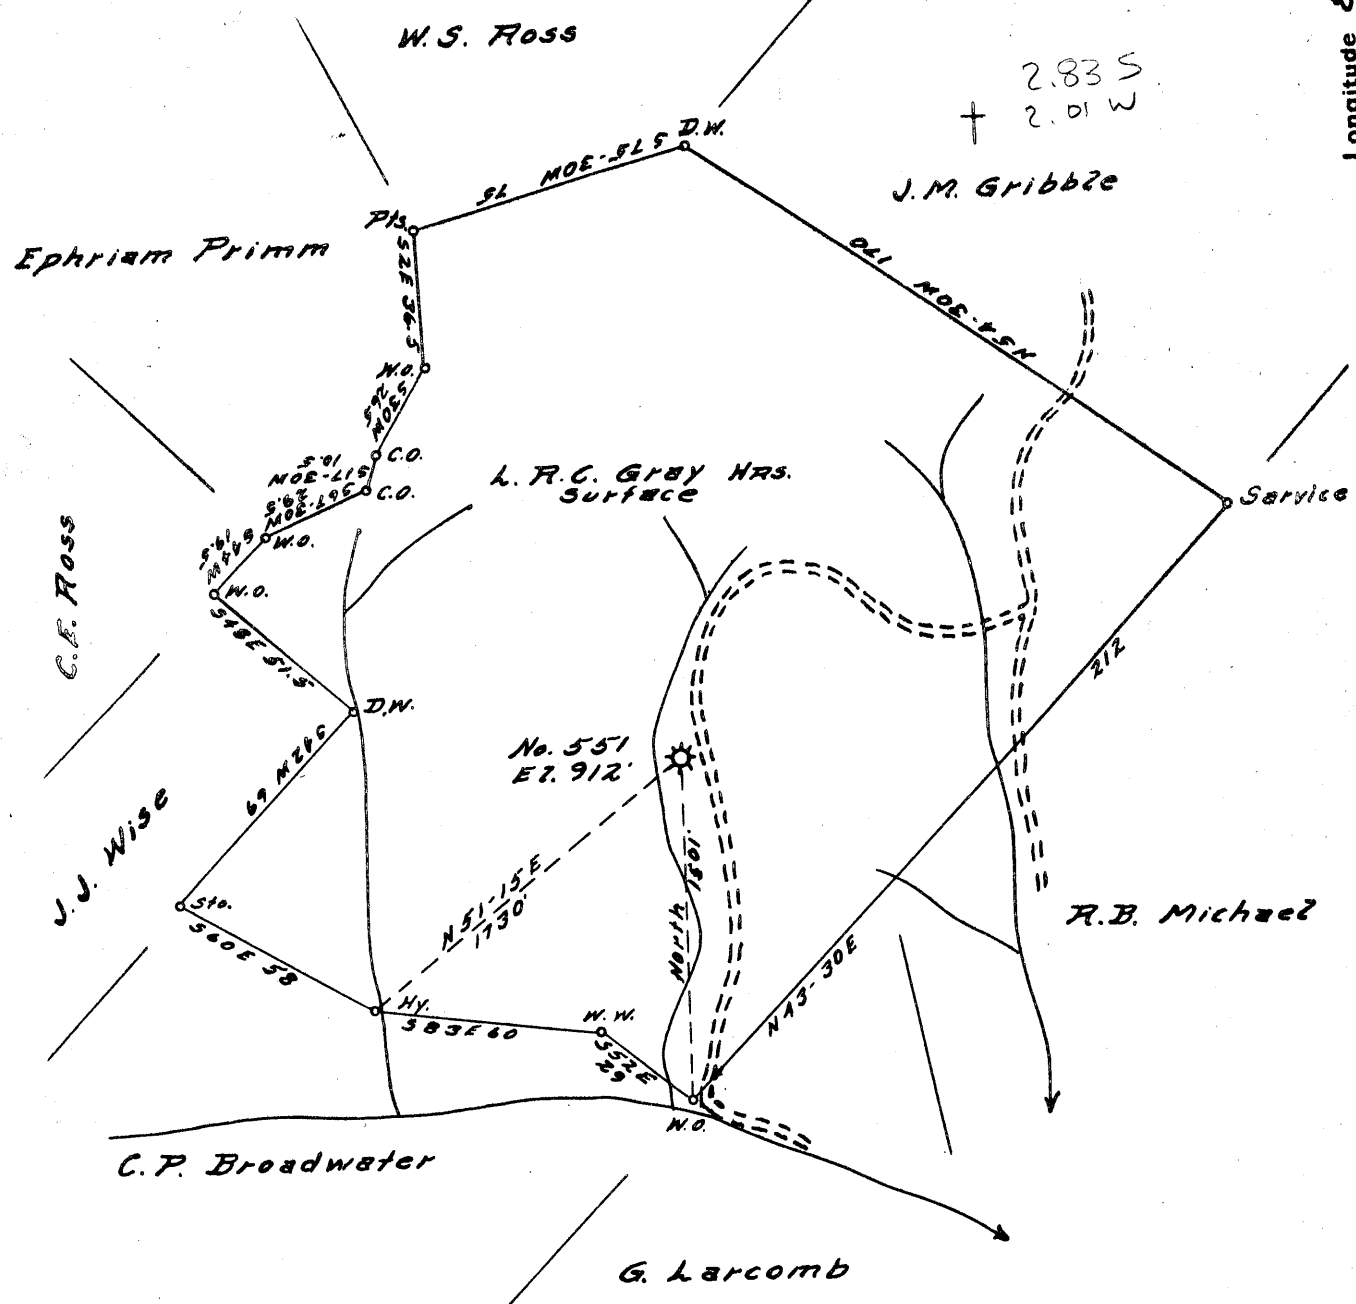

- New Location...
- Drill Deeper.....
- Abandonment.....

Company CARNEGIE NATURAL GAS
 Address PITTSBURGH, PA.
 Farm HANNAH WALDO
 Tract _____ Acres 225 Lease No. E-7787-17
 Well (Farm) No. 1 Serial No. E551
 Elevation (Spirit Level) 912'
 Quadrangle HOLBROOK NE.
 County DODDRIDGE District SOUTHWEST
 Engineer J. M. Gribbze
 Engineer's Registration No. 1850
 File No. _____ Drawing No. _____
 Date 5-14-53 Scale 1" = 50 Poles

STATE OF WEST VIRGINIA
 DEPARTMENT OF MINES
 OIL AND GAS DIVISION
 CHARLESTON

WELL LOCATION MAP
 FILE NO. DOD-992-A

+ Denotes location of well on United States Topographic Maps, scale 1 to 62,500, latitude and longitude lines being represented by border lines as shown.

- Denotes one inch spaces on border line of original tracing.



STATE OF WEST VIRGINIA
DEPARTMENT OF MINES
OIL AND GAS DIVISION

947

WELL RECORD
GAS WELL TO BE ABANDONED

Permit No. 992-A


Oil or Gas Well Gas
(KIND)

Company Carnegie Natural Gas Company
Address 1015 Frick Bldg., Pittsburgh 19, Pa.
Farm Hannah Waldo Acres 225
Location (waters) _____
Well No. 551 Elev. 912
District Southwest County Doddridge
The surface of tract is owned in fee by Heirs of Hannah Waldo Grey Address West Union, W. Va.
Mineral rights are owned by Same Address _____
Drilling commenced 10-2-15
Drilling completed 1-20-16
Date Shot _____ From 1820 To 1829
With 30 quarts and 50 quarts
Open Flow /10ths Water in _____ Inch
/10ths Merc. in _____ Inch
Volume _____ Cu. Ft.
Rock Pressure _____ lbs. _____ hrs.
Oil _____ bbls., 1st 24 hrs.
Fresh water _____ feet _____ feet
Salt water _____ feet _____ feet

Casing and Tubing	Used in Drilling	Left in Well	Packers
Size			
16			Kind of Packer
13			
10	<u>310</u>	<u>None</u>	Size of
8 3/4	<u>1060</u>	<u>None</u>	
6 3/4	<u>1750</u>	<u>1750</u>	Depth set
5 3/16	<u>1872</u>	<u>1872</u>	
3			Perf. top
2			Perf. bottom
Liners Used			Perf. top
			Perf. bottom

CASING CEMENTED _____ SIZE _____ No. Ft. _____ Date _____
COAL WAS ENCOUNTERED AT _____ FEET _____ INCHES
_____ FEET _____ INCHES FEET _____ INCHES
_____ FEET _____ INCHES FEET _____ INCHES

Formation	Color	Hard or Soft	Top	Bottom	Oil, Gas or Water	Depth Found	Remarks
Little Dunkard			860	881			
Big Dunkard			1060	1083			
Gas Sand			1135	1150			
1st Salt Sand			1603	1666			
2nd Salt Sand			1678	1715			
Maxon Sand			1817	1832	<u>Oil</u>	<u>1822 - 1827</u>	
Little Lime			1835	1850			
Pencil Cave			1850	1855			
Big Lime			1855	1933			
Big Injun			1933	1976	<u>Gas</u>	<u>1943 & 1951</u>	
TOTAL DEPTH				2039			

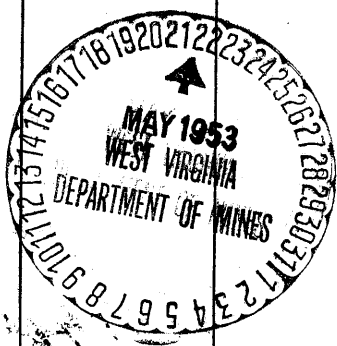

Formation	Color	Hard or Soft	Top	Bottom	Oil, Gas or Water	Depth Found	Remarks

Date May 21, 1953

APPROVED CARNEGIE NATURAL GAS COMPANY, Owner

By B. N. Tucker
(Title)

Land Agent.