

New Location..
 Drill Deeper.....
 Abandonment.....

| | |
|-----------------------------|---|
| Company | <u>MACKEY & WHITE</u> |
| Address | <u>RAVEN ROCK, W. VA.</u> |
| Farm | <u>LEROY LEESON</u> |
| Tract | Acres <u>29</u> Lease No. _____ |
| Well (Farm) No. | <u>1</u> Serial No. _____ |
| Elevation (Spirit Level) | <u>898</u> |
| Quadrangle | <u>HOLBROOK</u> |
| County | <u>DODDRIDGE</u> District <u>CENTRAL</u> |
| Engineer | <u>B. F. RINEHART</u> |
| Engineer's Registration No. | <u>648</u> |
| File No. | Drawing No. <u>961-CD</u> |
| Date | <u>June 30, 1953</u> Scale <u>1 in. = 300 ft.</u> |

STATE OF WEST VIRGINIA
 DEPARTMENT OF MINES
 OIL AND GAS DIVISION
 CHARLESTON

WELL LOCATION MAP
 FILE NO. DOD-1006-A

+ Denotes location of well on United States Topographic Maps, scale 1 to 62,500, latitude and longitude lines being represented by border lines as shown.
 - Denotes one inch spaces on border line of original tracing.



STATE OF WEST VIRGINIA
DEPARTMENT OF MINES
OIL AND GAS DIVISION

WELL RECORD

954

Permit No. 1006-A

Oil or Gas Well X (KIND)


Company Mackey & White
 Address Raven Rock, W.Va.
 Farm Leroy Leason Acres 29
 Location (waters) Leason Run
 Well No. I Elev. 898
 District Central County Doddridge
 The surface of tract is owned in fee by Leroy Leason
Greenwood, W.Va. Address _____
 Mineral rights are owned by Same
 Address _____
 Drilling commenced _____
 Drilling completed 1919
 Date Shot _____ From _____ To _____
 With _____
 Open Flow _____ /10ths Water in _____ Inch
 _____ /10ths Merc. in _____ Inch
 Volume _____ Cu. Ft.
 Rock Pressure _____ lbs. _____ hrs.
 Oil Not producing bbls., 1st 24 hrs.
 Fresh water _____ feet _____ feet
 Salt water _____ feet _____ feet

| Casing and Tubing | Used in Drilling | Left in Well | Packers |
|-------------------|------------------|--------------|----------------|
| Size | | | |
| 16 | | | Kind of Packer |
| 13 | | | |
| 10 | 255 | none | Size of |
| 8 1/4 | 1190 | none | |
| 6 5/8 | 1997 | 1997 | Depth set |
| 5 3/16 | none | none | |
| 3 | | | Perf. top |
| 2 | XIX | 2075 | Perf. bottom |
| Liners Used | | | Perf. top |
| | | | Perf. bottom |

CASING CEMENTED _____ SIZE _____ No. Ft. _____ Date _____

COAL WAS ENCOUNTERED AT _____ FEET _____ INCHES
 _____ FEET _____ INCHES FEET _____ INCHES
 _____ FEET _____ INCHES FEET _____ INCHES

| Formation | Color | Hard or Soft | Top | Bottom | Oil, Gas or Water | Depth Found | Remarks |
|-----------|-------|--------------|------------------|--------|-------------------|-------------|---------|
| | | | 1500 | 1610 | | | |
| | | | 1680 | 1760 | | | |
| | | | 1908 | 1935 | | | |
| | | | 1990 | 2050 | | | |
| | | | 2050 | 2089. | | | |
| | | | Tot. Depth 2089. | | | | |

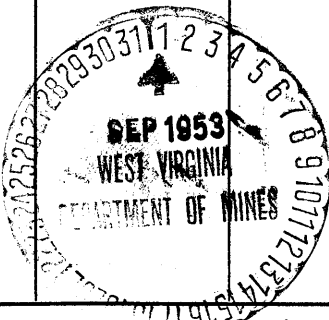

JAN 2 1954
JAN 2 1954

JAN 2 REC'D

(Over)

| Formation | Color | Hard or Soft | Top | Bottom | Oil, Gas or Water | Depth Found | Remarks |
|-----------|-------|--------------|-----|--------|-------------------|-------------|---------|
| | | | | | | | Σ |

Date Aug. 29, 1953, 19

APPROVED Mackey & White, Owner

By *Levi White* Partner
(Title)