


1 2 3

Latitude 39° 30'

Longitude 80° 40'

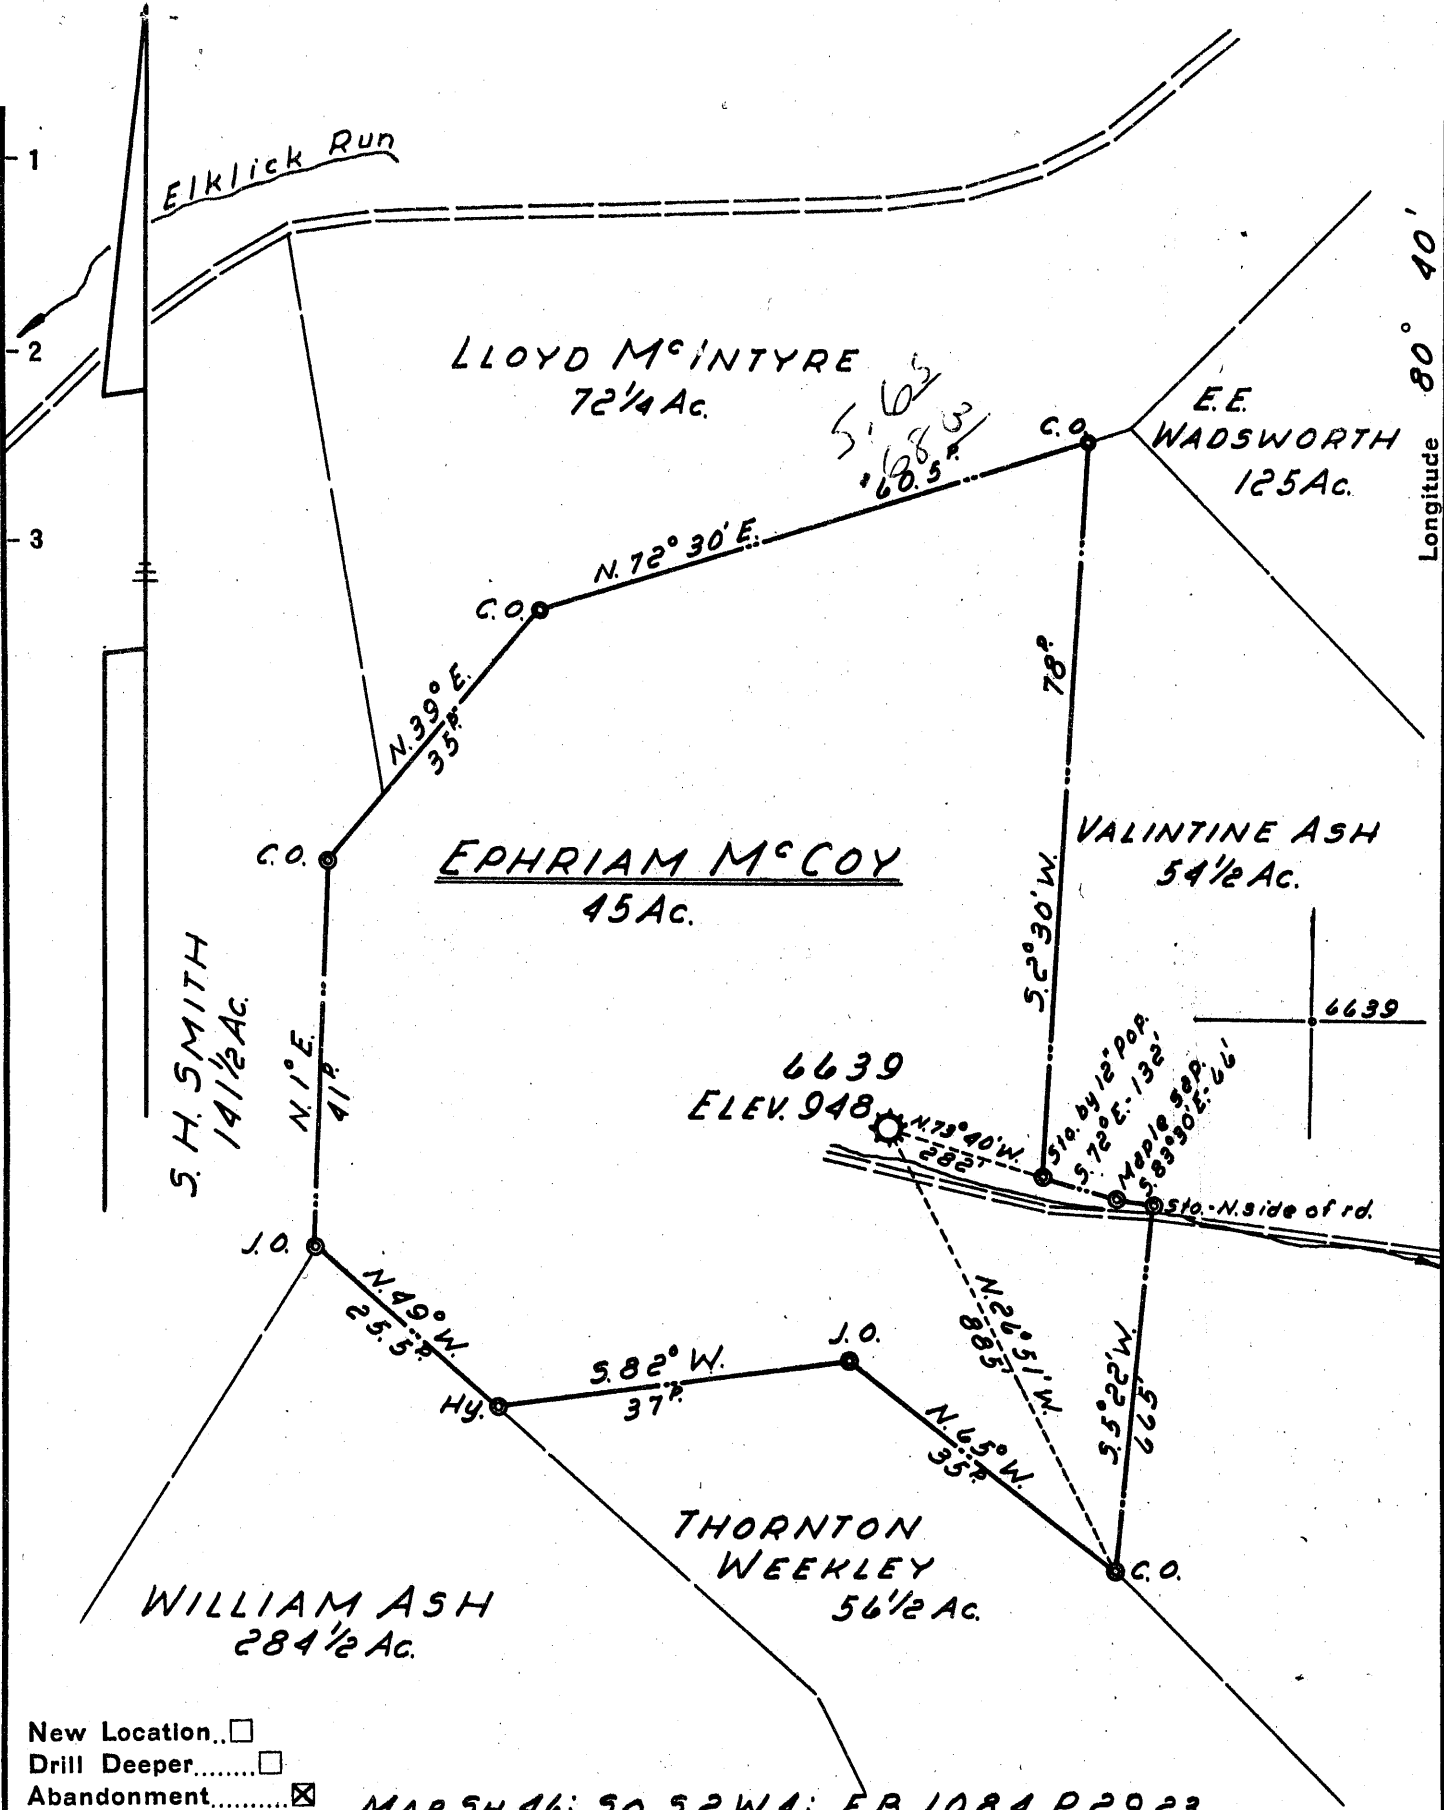

New Location...
 Drill Deeper...
 Abandonment...

MAP SH. 46: 50, S. 2 W. 4: F. B. 1084 P. 29, 23.

Company HOPE NATURAL GAS CO.
 Address CLARKSBURG, W.VA.
 Farm EPHRIAM M^cCOY
 Tract _____ Acres 45 Lease No. 36901
 Well (Farm) No. _____ Serial No. 6639
 Elevation (Spirit Level) 948'
 Quadrangle CENTERPOINT
 County DODDRIDGE District M^cCLELLAN
 Engineer Guy H. Bradley
 Engineer's Registration No. 2425
 File No. _____ Drawing No. _____
 Date 12-14-53 Scale 1" = 20 POLES

STATE OF WEST VIRGINIA
 DEPARTMENT OF MINES
 OIL AND GAS DIVISION
 CHARLESTON

WELL LOCATION MAP
 FILE NO. DOD - 1021-A

+ Denotes location of well on United States Topographic Maps, scale 1 to 62,500, latitude and longitude lines being represented by border lines as shown.

- Denotes one inch spaces on border line of original tracing.

JUC



STATE OF WEST VIRGINIA
DEPARTMENT OF MINES
OIL AND GAS DIVISION

986

WELL RECORD

Permit No. 1071-A

Oil or Gas Well Gas
(KIND)

Company Hope Natural Gas Company
 Address 445 West Main St., Clarksburg, W.Va.
 Farm Ephraim McCoy Acres 4.5
 Location (waters) _____
 Well No. 6639 Elev. 948'
 District McClellan County Doddridge
 The surface of tract is owned in fee by _____
 Address _____
 Mineral rights are owned by _____
 Address _____
 Drilling commenced 1-8-25
 Drilling completed 3-11-25
 Date Shot _____ From _____ To _____
 With _____
 Open Flow _____ /10ths Water in _____ Inch
 _____ /10ths Merc. in _____ Inch
 Volume _____ Cu. Ft.
 Rock Pressure _____ lbs. _____ hrs.
 Oil None bbls., 1st 24 hrs.
 Fresh water None feet _____ feet
 Salt water 2153 feet _____ feet

Casing and Tubing	Used in Drilling	Left in Well	Packers
Size			Kind of Packer
16			
13			
10			Size of
8 1/4			
6 3/4	2007	2007'	Depth set
5 3/16	2202	2202	
3			Perf. top
2			Perf. bottom
Liners Used			Perf. top
			Perf. bottom

CASING CEMENTED _____ SIZE _____ No. Ft. _____ Date _____
No cementing done
 COAL WAS ENCOUNTERED AT 368 FEET 36 INCHES
726 FEET 36 INCHES FEET INCHES
 FEET INCHES FEET INCHES

Formation	Color	Hard or Soft	Top	Bottom	Oil, Gas or Water	Depth Found	Remarks
Native Coal			368	371			
Pgh. Coal			726	729			
Little Dunkard	(None)						
Big Dunkard			1200	1235			
Gas Sand			1353	1378			
First Salt			1407 1407	1481			
2nd salt			1509	1590			
3rd Salt			1610	1704			
MAXON			1810	1830			
Little lime			1952	1995			
Pencil cave			1995	1998			
Blue Monday			1998	2023			
Big Lime			2023	2077			
Big Injun			2077	2229	Water	2153 Salt	Hole full
BEREA			2275	2295			
GANTZ			2330	2460			
FIFTY FOOT			2555	2580			
THIRTY FOOT			2585	2620			
GORDON STRAY			2778	2794			
GORDON			2794	2821	Gas	2820	
Total depth				2859'			

