



6) 4.525
 2.50 W
 8) 4.595
 2.42 W
 3) 4.585
 2.30 W
 11) 5.605
 2.78 W

11 6 8 3
 ++ +


SMITH HRS.

C. T. DARNELL
226 A

ELLIFRITTS

DARNELL

ADAMS

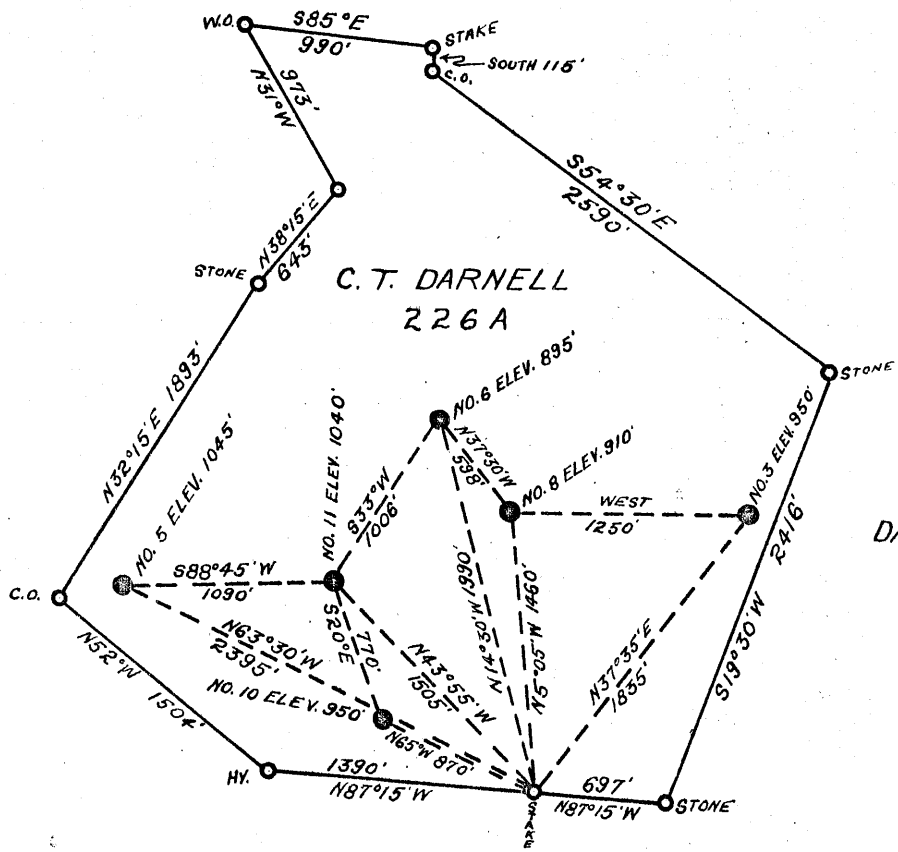

New Location...
 Drill Deeper.....
 Abandonment.....

DOD-1036-A-#6
 DOD-1037-A-#8

Company MACKEY & WHITE
 Address RAVEN ROCK, W. VA
 Farm C. T. DARNELL
 Tract _____ Acres 226 Lease No. _____
 Well (Farm) No. ABOVE Serial No. _____
 Elevation (Spirit Level) ABOVE
 Quadrangle WEST UNION
 County DODDRIDGE District CENTRAL
 Engineer Ronald W Morris
 SURVEYED BY J. F. DEEM
 Engineer's Registration No. 1653
 File No. _____ Drawing No. _____
 Date MARCH 23, 1954 Scale 1" = 1000'

STATE OF WEST VIRGINIA
 DEPARTMENT OF MINES
 OIL AND GAS DIVISION
 CHARLESTON

WELL LOCATION MAP
 FILE NO. DOD-1029-A-#3
DOD-1030-A-#11

+ Denotes location of well on United States Topographic Maps, scale 1 to 62,500, latitude and longitude lines being represented by border lines as shown.
 - Denotes one inch spaces on border line of original tracing.



STATE OF WEST VIRGINIA
DEPARTMENT OF MINES
OIL AND GAS DIVISION

WELL RECORD

Oil or Gas Well _____ (KIND)

Permit No. 1030/A

964


Company Mackey & White
Address Raven Rock, W.Va.
Farm C.T. Darnell Acres 336
Location (waters) Greenwood Hill
Well No. 11 Elev. 1040
District Central County Doddridge
The surface of tract is owned in fee by C.T. Darnell
Greenwood, Address W.Va.
Mineral rights are owned by C.T. Darnell and D.T. Mason hrs
Address Greenwood, W.Va.
Drilling commenced _____
Drilling completed 1918
Date Shot _____ From _____ To _____
With _____

Casing and Tubing	Used in Drilling	Left in Well	Packers
Size			Kind of Packer
16			
13	1220		
10	290	none	Size of
8 1/4	1210	#	
6 1/2	1985	1985	Depth set
5 3/16	2030 5	3/16	
3	run in well		Perf. top
2	as liner		Perf. bottom
Liners Used			Perf. top
			Perf. bottom

Open Flow _____ /10ths Water in _____ Inch
_____ /10ths Merc. in _____ Inch
Volume _____ Cu. Ft.
Rock Pressure _____ lbs. _____ hrs.
Oil _____ bbls., 1st 24 hrs.
Fresh water _____ feet _____ feet
Salt water _____ feet _____ feet

CASING CEMENTED _____ SIZE _____ No. Ft. _____ Date _____
COAL WAS ENCOUNTERED AT _____ FEET _____ INCHES
_____ FEET _____ INCHES _____ FEET _____ INCHES
_____ FEET _____ INCHES _____ FEET _____ INCHES

Formation	Color	Hard or Soft	Top	Bottom	Oil, Gas or Water	Depth Found	Remarks
1st. Salt sand			1560	1620	C		
2nd. "			1715	1725			
Maxon Sand			1925	1945			
Big Lime			1971	2067			
Big Injun			2087	2112			
			2087	2141			
		Total depth.					

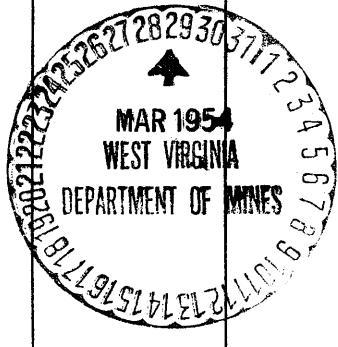

Formation	Color	Hard or Soft	Top	Bottom	Oil, Gas or Water	Depth Found	Remarks

Date May 26, 1954

APPROVED Edw E. White, Owner

By Stanton
(Title)