

Latitude 39° 20'

Longitude 80° 50'



SMITH HRS.

ELLIFRITTS

C. T. DARNELL  
226 A

ADAMS

AUG 16 1954

#3	2,330 W
	4,100
#4	2,700 W
	4,100
#5	2,540 W
	4,100
#6	2,450 W
	4,600
#7	2,700 W
	4,700
#8	2,810 W
	4,700

DOD-1036-A-#6

DOD-1037-A-#8

- New Location...
- Drill Deeper...
- Abandonment...

Company MACKAY & WHITE  
 Address RAVEN ROCK, W. VA  
 Farm C. T. DARNELL  
 Tract \_\_\_\_\_ Acres 226 Lease No. \_\_\_\_\_  
 Well (Farm) No. ABOVE Serial No. \_\_\_\_\_  
 Elevation (Spirit Level) ABOVE  
 Quadrangle WEST UNION  
 County DODDRIDGE District CENTRAL  
 Engineer Donald W. Morris  
 SURVEYED BY J. F. DEEM  
 Engineer's Registration No. 1653  
 File No. \_\_\_\_\_ Drawing No. \_\_\_\_\_  
 Date MARCH 23, 1954 Scale 1"=1000'

STATE OF WEST VIRGINIA  
DEPARTMENT OF MINES  
OIL AND GAS DIVISION  
CHARLESTON

WELL LOCATION MAP

FILE NO. ~~DOD-1029-A-#3~~  
~~DOD-1030-A-#11~~

+ Denotes location of well on United States Topographic Maps, scale 1 to 62,500, latitude and longitude lines being represented by border lines as shown.

- Denotes one inch spaces on border line of original tracing.

(Nos. 6 & 8)  
C. T. DARNELL (Nos. 3 & 11) - MACKAY & WHITE - (DOD-1036-7-A)  
(DOD-1029-30-A)



STATE OF WEST VIRGINIA  
DEPARTMENT OF MINES  
OIL AND GAS DIVISION

910

West Union  
1977A

WELL RECORD

Permit No. 1977A


Oil or Gas Well \_\_\_\_\_ (KIND)

Company Mackey & White  
 Address Raven Rock, W.Va.  
 Farm C.T. Darnell Acres 326  
 Location (waters) \_\_\_\_\_  
 Well No. 8 Elev. 910  
 District Central County Doddridge  
 The surface of tract is owned in fee by C.T. Darnell  
Greenwood Address W.Va.  
 Mineral rights are owned by Same  
 Address \_\_\_\_\_  
 Drilling commenced 1917  
 Drilling completed 1966  
 Date Shot \_\_\_\_\_ From \_\_\_\_\_ To \_\_\_\_\_  
 With \_\_\_\_\_  
 Open Flow \_\_\_\_\_ /10ths Water in \_\_\_\_\_ Inch  
 \_\_\_\_\_ /10ths Merc. in \_\_\_\_\_ Inch  
 Volume \_\_\_\_\_ Cu. Ft.  
 Rock Pressure \_\_\_\_\_ lbs. \_\_\_\_\_ hrs.  
 Oil \_\_\_\_\_ bbls., 1st 24 hrs.  
 Fresh water \_\_\_\_\_ feet \_\_\_\_\_ feet  
 Salt water \_\_\_\_\_ feet \_\_\_\_\_ feet

Casing and Tubing	Used in Drilling	Left in Well	Packers
Size			Kind of Packer
16			
13			
10	<b>443 x220</b>	<b>none</b>	Size of
8 1/4	<b>1040 x155</b>	<b>"</b>	Depth set
11 3/8	<b>1438</b>	<b>1438</b>	Perf. top
17 5/8 16	<b>Run later</b>	<b>1805</b>	Perf. bottom
3			Perf. top
			Perf. bottom

CASING CEMENTED \_\_\_\_\_ SIZE \_\_\_\_\_ No. Ft. \_\_\_\_\_ Date \_\_\_\_\_  
 COAL WAS ENCOUNTERED AT \_\_\_\_\_ FEET \_\_\_\_\_ INCHES  
 \_\_\_\_\_ FEET \_\_\_\_\_ INCHES FEET \_\_\_\_\_ INCHES  
 \_\_\_\_\_ FEET \_\_\_\_\_ INCHES FEET \_\_\_\_\_ INCHES

Formation	Color	Hard or Soft	Top	Bottom	Oil, Gas or Water	Depth Found	Remarks
1st. Salt Sand			1375	1432			
Maxon Sand			1721	1764			
Big Lime			1800	1892			
Injun Sand			1892	1947			
			<b>Total Depth 2049</b>				

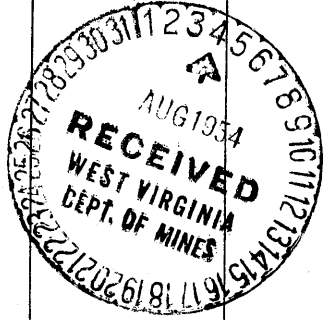

Formation	Color	Hard or Soft	Top	Bottom	Oil, Gas or Water	Depth Found	Remarks

10

Date 5/2/54, 194

APPROVED *Edw E White*, Owner

By *Winters*  
(Title)

