


Latitude 39° 30'

Longitude 80° 40'

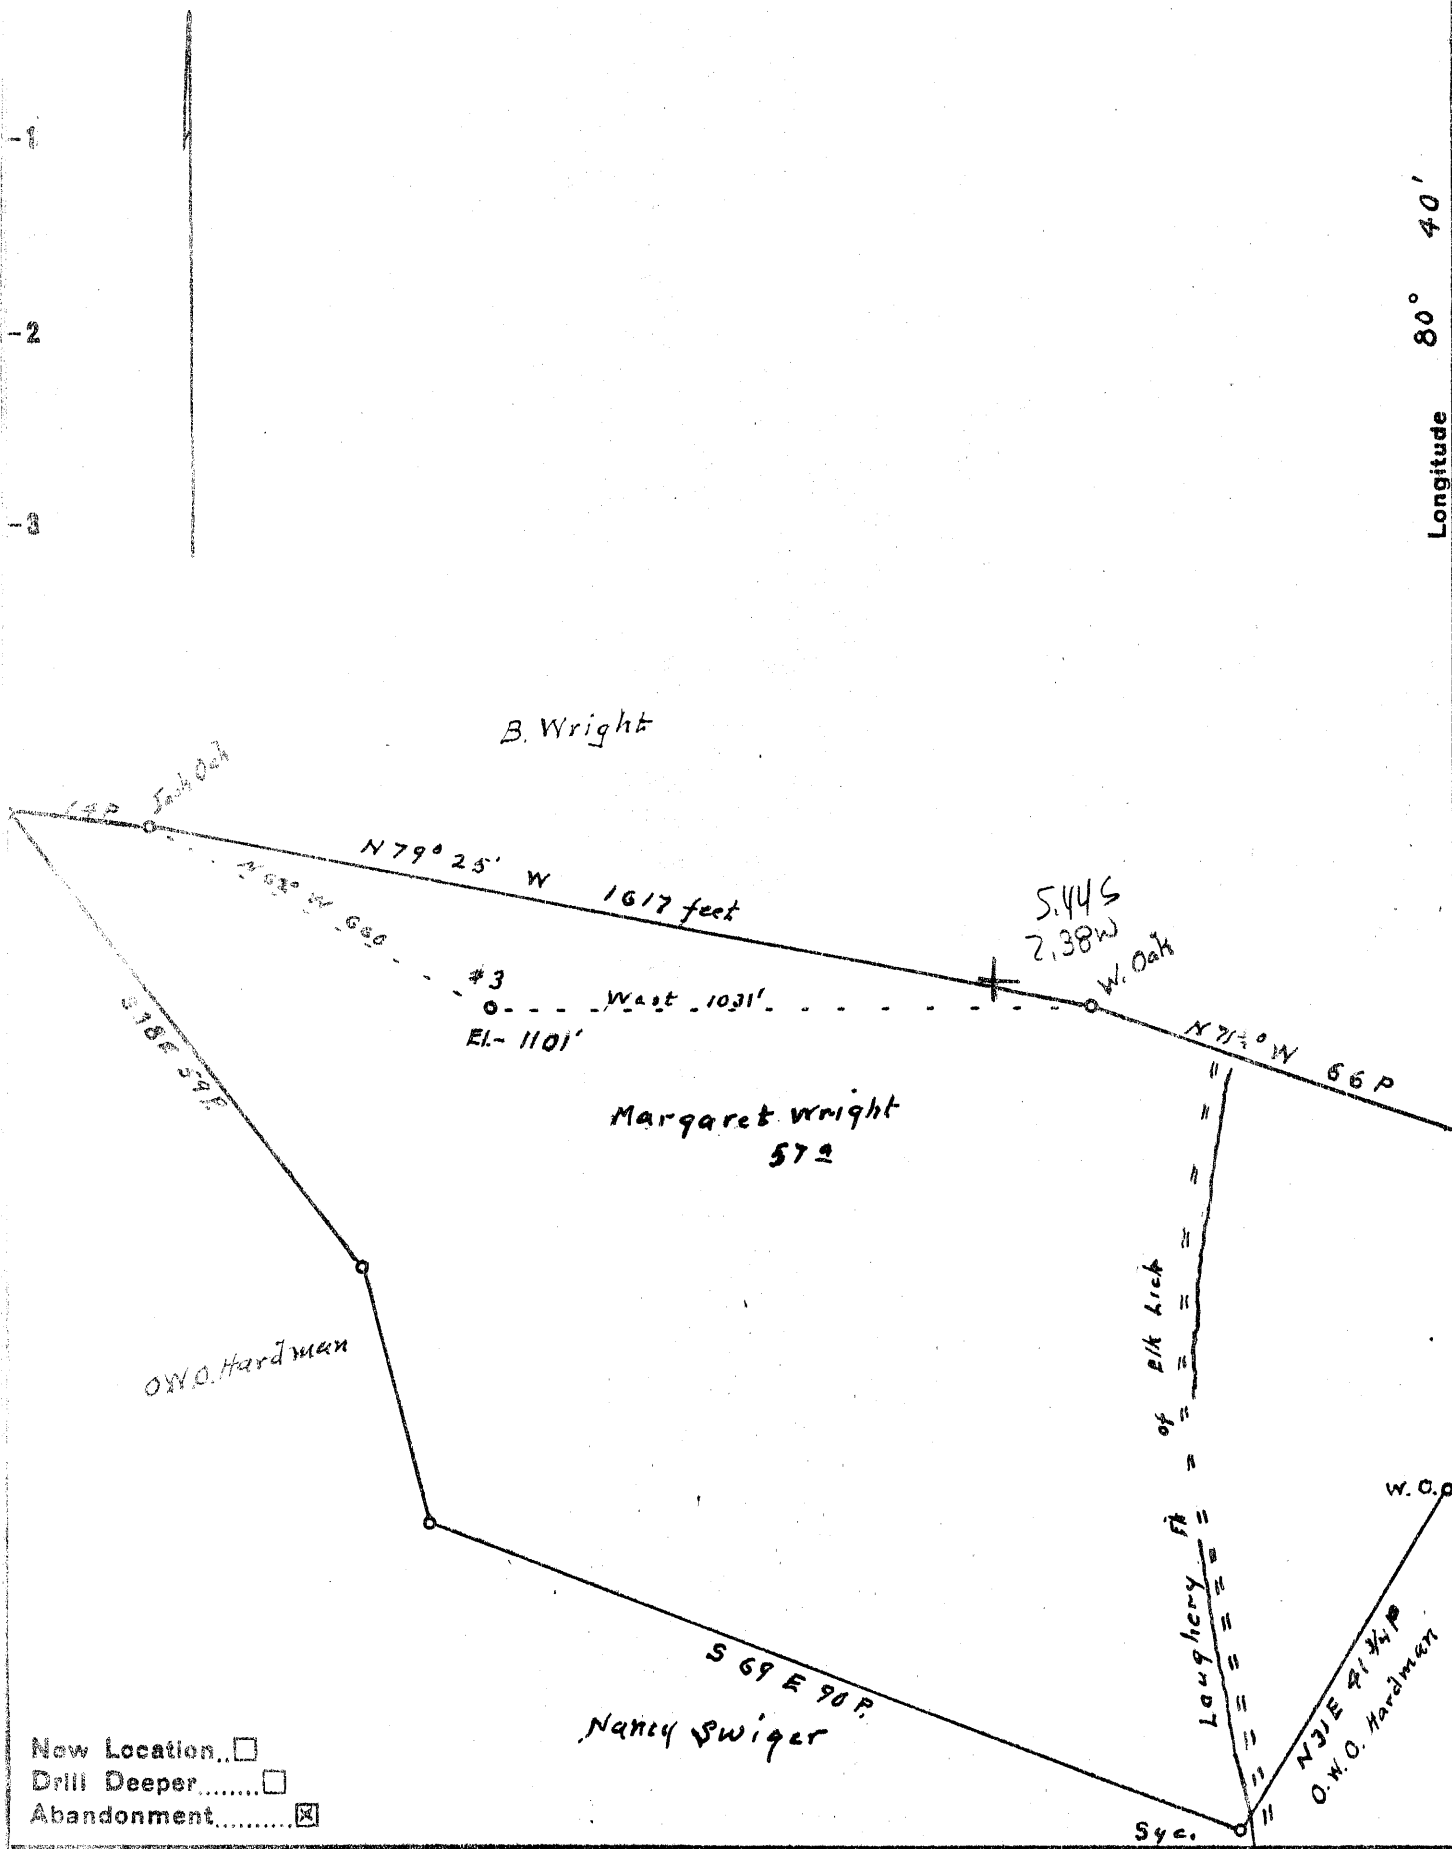

New Location...
 Drill Deeper.....
 Abandonment.....

Company Pierson Smith Feisk & Kirshbride
 Address R2 Walker W. Va.
 Farm Margaret Wright
 Tract _____ Acres 57 Lease No. _____
 Well (Farm) No. 3 Serial No. _____
 Elevation (Spirit Level) 1101
 Quadrangle Center point
 County Doddridge District McClellan
 Engineer Robert R Anderson
 Engineer's Registration No. 296
 File No. _____ Drawing No. _____
 Date 9/12 59 Scale 1 in = 20 Poles

STATE OF WEST VIRGINIA
 DEPARTMENT OF MINES
 OIL AND GAS DIVISION
 CHARLESTON

WELL LOCATION MAP
 FILE NO. DOD-1041-A

+ Denotes location of well on United States Topographic Maps, scale 1 to 62,500, latitude and longitude lines being represented by border lines as shown.

- Denotes one inch spaces on border line of original tracing.



STATE OF WEST VIRGINIA
DEPARTMENT OF MINES
OIL AND GAS DIVISION

WELL RECORD

993

Permit No. 1041-A


Oil or Gas Well _____ (KIND)

Company Piersol Smith, Feick & Kirkbride
 Address Walker, Rt. 2 W. Va
 Farm Margaret Wright Acres 5
 Location (waters) Laughery Fork
 Well No. 3 Elev. 1101
 District McClellan County Woodridge
 The surface of tract is owned in fee by Amery Parker
 Post Office Address W. Va
 Mineral rights are owned by same
 Address _____
 Drilling commenced 1898
 Drilling completed _____
 Date Shot _____ From _____ To _____
 With _____
 Open Flow _____ /10ths Water in _____ Inch
 _____ /10ths Merc. in _____ Inch
 Volume _____ Cu. Ft.
 Rock Pressure _____ lbs. _____ hrs.
 Oil _____ bbls., 1st 24 hrs.
 Fresh water _____ feet _____ feet
 Salt water _____ feet _____ feet

Casing and Tubing	Used in Drilling	Left in Well	Packers
Size			
16			Kind of Packer
13			
10	470'	none	Size of
8 3/4	1329	none	
6 5/8	2175	2175	Depth set
5 3/16	442	442	
3			Perf. top
2			Perf. bottom
Liners Used			Perf. top
			Perf. bottom

CASING CEMENTED _____ SIZE _____ No. Ft. _____ Date _____
 COAL WAS ENCOUNTERED AT _____ FEET _____ INCHES
 _____ FEET _____ INCHES FEET _____ INCHES
 _____ FEET _____ INCHES FEET _____ INCHES

Formation	Color	Hard or Soft	Top	Bottom	Oil, Gas or Water	Depth Found	Remarks
	clay & red rock		000	825			
	cave		825	925			
	shale & slate		925	1450			
	salt sand		1450	1475			
	slate & lime		1475	2205			
	oil pay		2205	2220	Injunct.		
	total depth		2220				

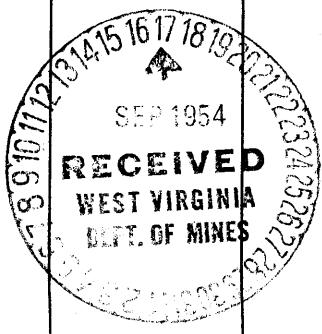

APR 22 1955

Formation	Color	Hard or Soft	Top	Bottom	Oil, Gas or Water	Depth Found	Remarks

Date 9-12- 1954

APPROVED Pierced Smith, Fuchs & Kirkland, Owner

By P. R. Pierced
(Title)