


Latitude 39° 25'

Longitude 80° 35'

-1
-2
-3

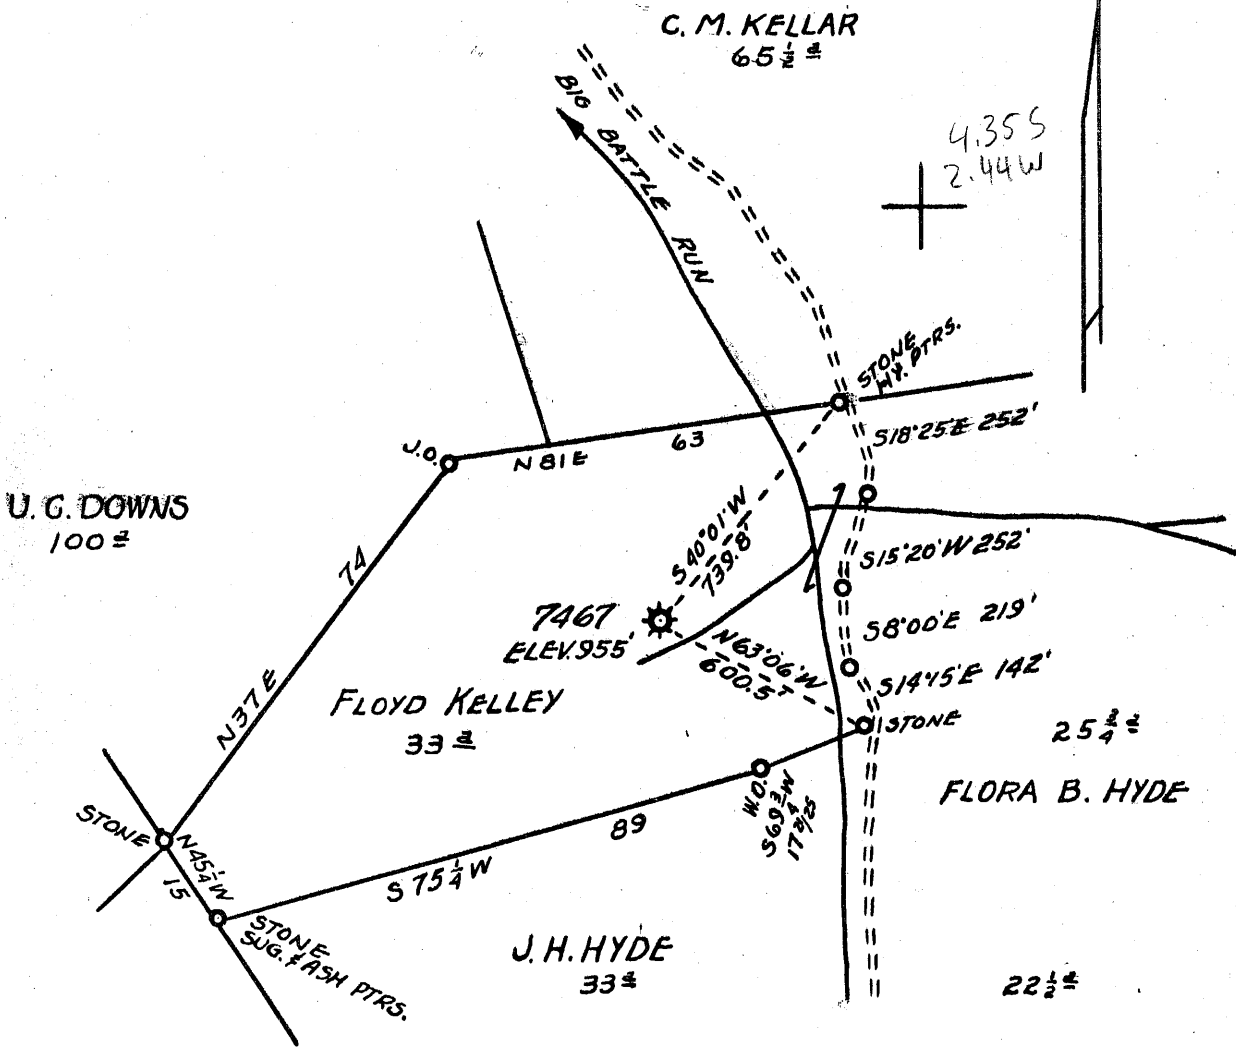

New Location...
 Drill Deeper.....
 Abandonment.....

MAP 54 S-7 W-1 F.B. 493 P 3-5-39

Company HOPE NATURAL GAS COMPANY
 Address CLARKSBURG, W. VA.
 Farm FLOYD KELLEY
 Tract _____ Acres 33 Lease No. 45005
 Well (Farm) No. _____ Serial No. 7467
 Elevation (Spirit Level) 955.0'
 Quadrangle CENTERPOINT, W.VA.
 County DODDRIDGE District MCLELLAN
 Engineer W.M. Bowers
 Engineer's Registration No. 900
 File No. _____ Drawing No. _____
 Date JANUARY 18, 1955 Scale 1" = 500'

STATE OF WEST VIRGINIA
 DEPARTMENT OF MINES
 OIL AND GAS DIVISION
 CHARLESTON

WELL LOCATION MAP
 FILE NO. DOD-1044-A

+ Denotes location of well on United States Topographic Maps, scale 1 to 62,500, latitude and longitude lines being represented by border lines as shown.

- Denotes one inch spaces on border line of original tracing.

72838 ON CNG MAPS



STATE OF WEST VIRGINIA
DEPARTMENT OF MINES
OIL AND GAS DIVISION

992

Quadrangle

Permit No. 1045-A

WELL RECORD

Oil or Gas Well Gas
(KIND)


Company Hope Natural Gas Company
 Address 445 West Main St., Clarksburg, W. Va.
 Farm Floyd Kelley Acres 33
 Location (waters)
 Well No. 7467 Elev. 155
 District McClellan County Doddridge
 The surface of tract is owned in fee by
 Address
 Mineral rights are owned by
 Address
 Drilling commenced 9-17-23
 Drilling completed 10-24-23
 Date Shot Oct. 1923 From 1988 To 1992
 With 40 Qts

Casing and Tubing	Used in Drilling	Left in Well	Packers
Size			Kind of Packer
16			
13			
10	813	813	Size of
8 1/4	1818	1818	Depth set
6 5/8			
5 3/16			
3	2076	2076	Perf. top
2			Perf. bottom
Liners Used			Perf. top
			Perf. bottom

Open Flow /10ths Water in Inch
 /10ths Merc. in Inch
 Volume Cu. Ft.
 Rock Pressure lbs. hrs.
 Oil None bbls., 1st 24 hrs.
 Fresh water 270-273 feet feet
 Salt water feet feet

CASING CEMENTED SIZE No. Ft. Date
No Cementing
 COAL WAS ENCOUNTERED AT 270 FEET 36 INCHES
539 FEET 96 INCHES
 FEET INCHES
 FEET INCHES

Formation	Color	Hard or Soft	Top	Bottom	Oil, Gas or Water	Depth Found	Remarks
Coal			270	273			
Pittsburgh Coal			539	547	Water		
Little Dunkard			920	970	Water		
Big Dunkard			1040	1080			
Gas Sand			1175	1250			
First Salt			1250	1365			
Maxon			1730	1755			
Little Lime			1775	1811			
Pencil Cave			1811	1814			
Big Lime			1814	1860	Gas	1860	
Big Injun			1860	2025	Gas	1914 & 1990'	
Total Depth				2076'			

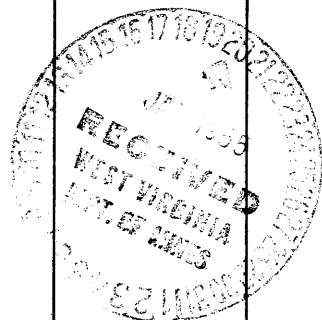

APR 22 1955

Formation	Color	Hard or Soft	Top	Bottom	Oil, Gas or Water	Depth Found	Remarks

Date January 18, 1955

APPROVED Hope Natural Gas Company, Owner

By _____ (Title) *Sailey*