


0
1
2
3

3.87 1/2
55 1/2

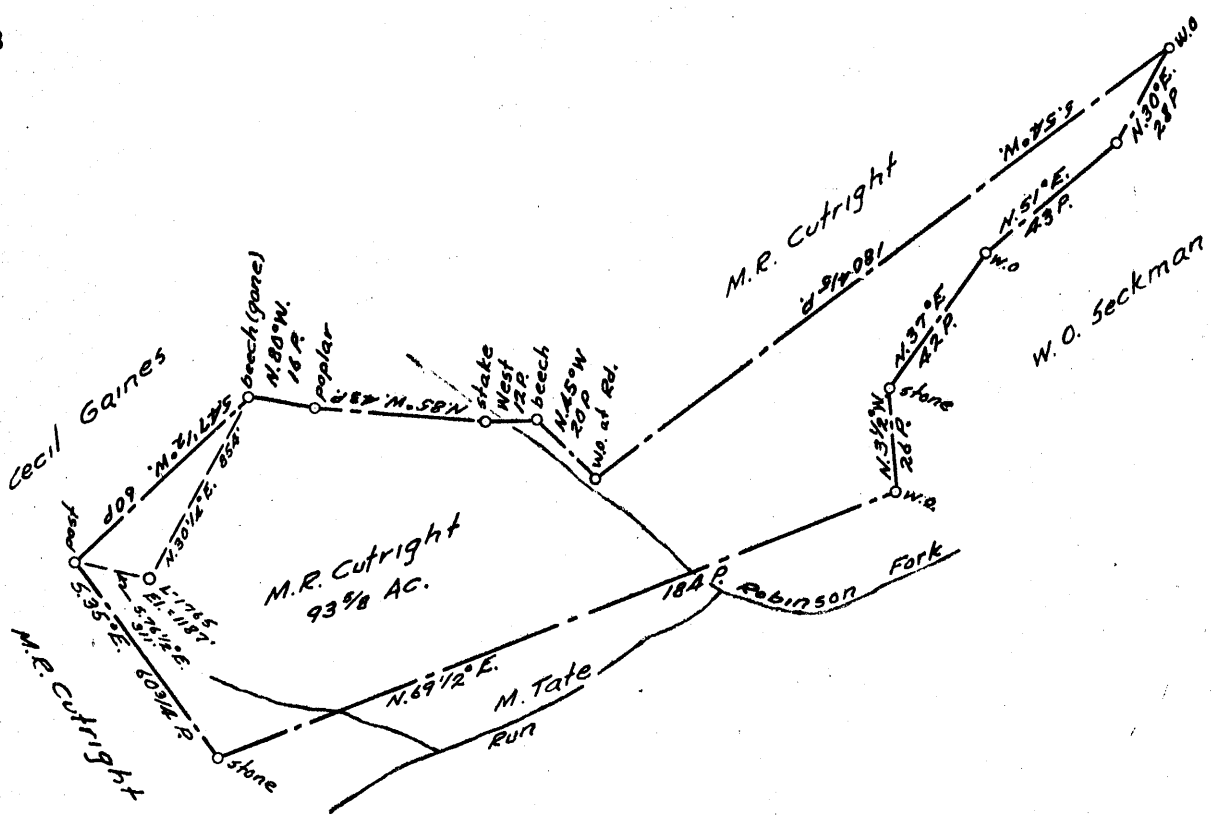

COAL OWNED BY _____

NEW LOCATION.....
 DRILL DEEPER.....
 ABANDONMENT.....

COMPANY The Manufacturers Light & Heat Co.
 ADDRESS 800 Union Trust Bldg. Pgh. Pa.
 FARM M.R. Cutright
 TRACT _____ ACRES 93 3/8 LEASE NO. 4881
 WELL (FARM) NO. 1 SERIAL NO. 1765
 ELEVATION (SPIRIT LEVEL) 1187'
 QUADRANGLE Centerpoint
 COUNTY Doddridge DISTRICT McClellan
 ENGINEER Thomas E. Virgin - J.M.
 ENGINEER'S REGISTRATION NO. 1503
 FILE NO. _____ DRAWING NO. Y-15-258
 DATE 27 June 1955 SCALE 1" = 800'

STATE OF WEST VIRGINIA
 DEPARTMENT OF MINES
 OIL AND GAS DIVISION
 CHARLESTON

WELL LOCATION MAP

FILE No. DOD-1049-A

+ DENOTES LOCATION OF WELL ON UNITED STATES TOPOGRAPHIC MAPS. SCALE 1 TO 62,500, LATITUDE AND LONGITUDE LINES BEING REPRESENTED BY BORDER LINES AS SHOWN.

- DENOTES ONE INCH SPACES ON BORDER LINE OF ORIGINAL TRACING.



STATE OF WEST VIRGINIA
DEPARTMENT OF MINES
OIL AND GAS DIVISION

1016

Quadrangle Centerspit

WELL RECORD

Permit No. 1049A

Oil or Gas Well Gas
(KIND)

Company THE MANUFACTURERS LIGHT AND HEAT CO.
Address 800 Union Trust Bldg., Pgh., Penna.
Farm M. R. Gutright Acres 65
Location (waters) _____
Well No. 1765 Elev. 1187'
District McClellan County Doddridge
The surface of tract is owned in fee by _____
Address _____
Mineral rights are owned by _____
Address _____
Drilling commenced August 27, 1914
Drilling completed October 14, 1914
Date Shot _____ From _____ To _____
With _____
Open Flow 100/10ths Water in _____ 2 Inch
_____ /10ths Merc. in _____ Inch
Volume 476,000 Cu. Ft.
Rock Pressure 65 lbs. 1 hrs.
Oil _____ bbls., 1st 24 hrs.
Fresh water _____ feet _____ feet
Salt water _____ feet _____ feet

Casing and Tubing	Used in Drilling	Left in Well	Packers
Size			Kind of Packer
16			
18			
10	415		Size of
8 1/4	1382		
6 5/8	2155	2155	Depth set
5 3/16	2892	2892	
3			Perf. top
2			Perf. bottom
Liners Used			Perf. top
			Perf. bottom

CASING CEMENTED _____ SIZE _____ No. Ft. _____ Date _____

COAL WAS ENCOUNTERED AT 310 FEET INCHES
836 FEET INCHES FEET INCHES
FEET INCHES FEET INCHES

Formation	Color	Hard or Soft	Top	Bottom	Oil, Gas or Water	Depth Found	Remarks
Native Coal			310	315			
Pittsburgh Coal			836	844			
Little Dunkard			1240	1264			
Big Dunkard			1370	1440			
Gas Sand			1510	1550			
1st Salt Sand			1590	1640			
2nd Salt Sand			1690	1765			
Maxon			1875	1990			
Little Lime			2057	2075			
Pencil Cave			2075	2090			
Big Lime			2090	2142			
Big Injun			2142	2277			
Squaw			2305	2320			
Burea			2400	2430			
Gantz			2650	2660			
Fifty Foot			2750	2775			
Thirty Foot			2835	2850			
Gordon Stray			2862	2883			
Gordon			2916	2922			
Fourth Sand			2950	2957			
Gas			2953	2963			
Slate			2965				
Total Depth			2989				



JUN 20 1957

