

New Location..
 Drill Deeper.....
 Abandonment.....

Map Sht. 68; S-21, W-10; F.B. 1129, P.30.

Company HOPE NATURAL GAS CO.
 Address CLARKSBURG, W. VA.
 Farm THURMAN SPURGEON
 Tract _____ Acres 170 Lease No. 34818
 Well (Farm) No. _____ Serial No. 5434
 Elevation (Spirit Level) 875'
 Quadrangle HOLBROOK
 County DODDRIDGE District COVE
 Engineer Guy H. Bradley
 Engineer's Registration No. 2425
 File No. _____ Drawing No. _____
 Date Oct. 20, 1955 Scale 1" = 40 POLES

STATE OF WEST VIRGINIA
 DEPARTMENT OF MINES
 OIL AND GAS DIVISION
 CHARLESTON

WELL LOCATION MAP
 FILE NO. DOD-1052-A

+ Denotes location of well on United States Topographic Maps, scale 1 to 62,500, latitude and longitude lines being represented by border lines as shown.

- Denotes one inch spaces on border line of original tracing.



STATE OF WEST VIRGINIA
DEPARTMENT OF MINES
OIL AND GAS DIVISION

1007

Quadrangle Holbrook

WELL RECORD

Permit No. 1007-A

Oil or Gas Well Gas
(KIND)

Company Hope Natural Gas Company
Address 445 West Main St., Clarksburg, W.Va.
Farm Thurman Spurgeon Acres 170
Location (waters) _____
Well No. 5434 Elev. 875'
District Cove County Doddridge

The surface of tract is owned in fee by _____
Address _____

Mineral rights are owned by _____
Address _____

Drilling commenced 12-23-18

Drilling completed 1-8-19

Date Shot Not shot From _____ To _____

With _____

Open Flow _____ /10ths Water in _____ Inch

_____ /10ths Merc. in _____ Inch

Volume Exhausted Cu. Ft.

Rock Pressure _____ lbs. _____ hrs.

Oil 1655' bbls., 1st 24 hrs.

Fresh water No record feet _____ feet


Salt water do feet _____ feet

Casing and Tubing	Used in Drilling	Left in Well	Packers
Size			Kind of Packer
16			
13			
10	235	235	Size of
8 1/4	898	898	
6 1/2	1702	1702	Depth set
5 3/16			
3			Perf. top
2			Perf. bottom
Liners Used			Perf. top
			Perf. bottom

CASING CEMENTED _____ SIZE _____ No. Ft. _____ Date _____
No record of any cementing

COAL WAS ENCOUNTERED AT _____ FEET _____ INCHES
No Coal
_____ FEET _____ INCHES FEET _____ INCHES
_____ FEET _____ INCHES FEET _____ INCHES

Formation	Color	Hard or Soft	Top	Bottom	Oil, Gas or Water	Depth Found	Remarks
Big Dunkard			777	1022			
Gas Sand			1065	1095			
First Salt			1262	1339			
Second Salt			1475	1525	Gas	1507'	
Little Lime			1620'	1641			
Pencil Cave			1641	1649			
Big Lime			1659	1723	Gas	1655'	
Big Injun			1723		Gas	1723	
Total Depth				1757'			

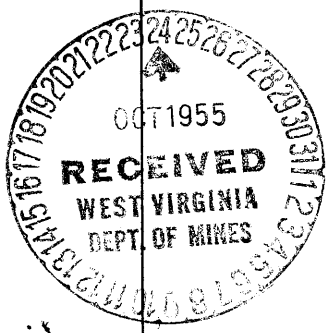

JUNE 21 1956

October 21, 1955

Pailey

Hope Natural Gas Company