



Latitude 39° 25'

Longitude 80° 40'

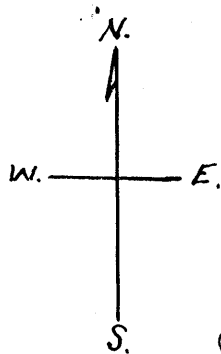

+ 170 S
1.93 W

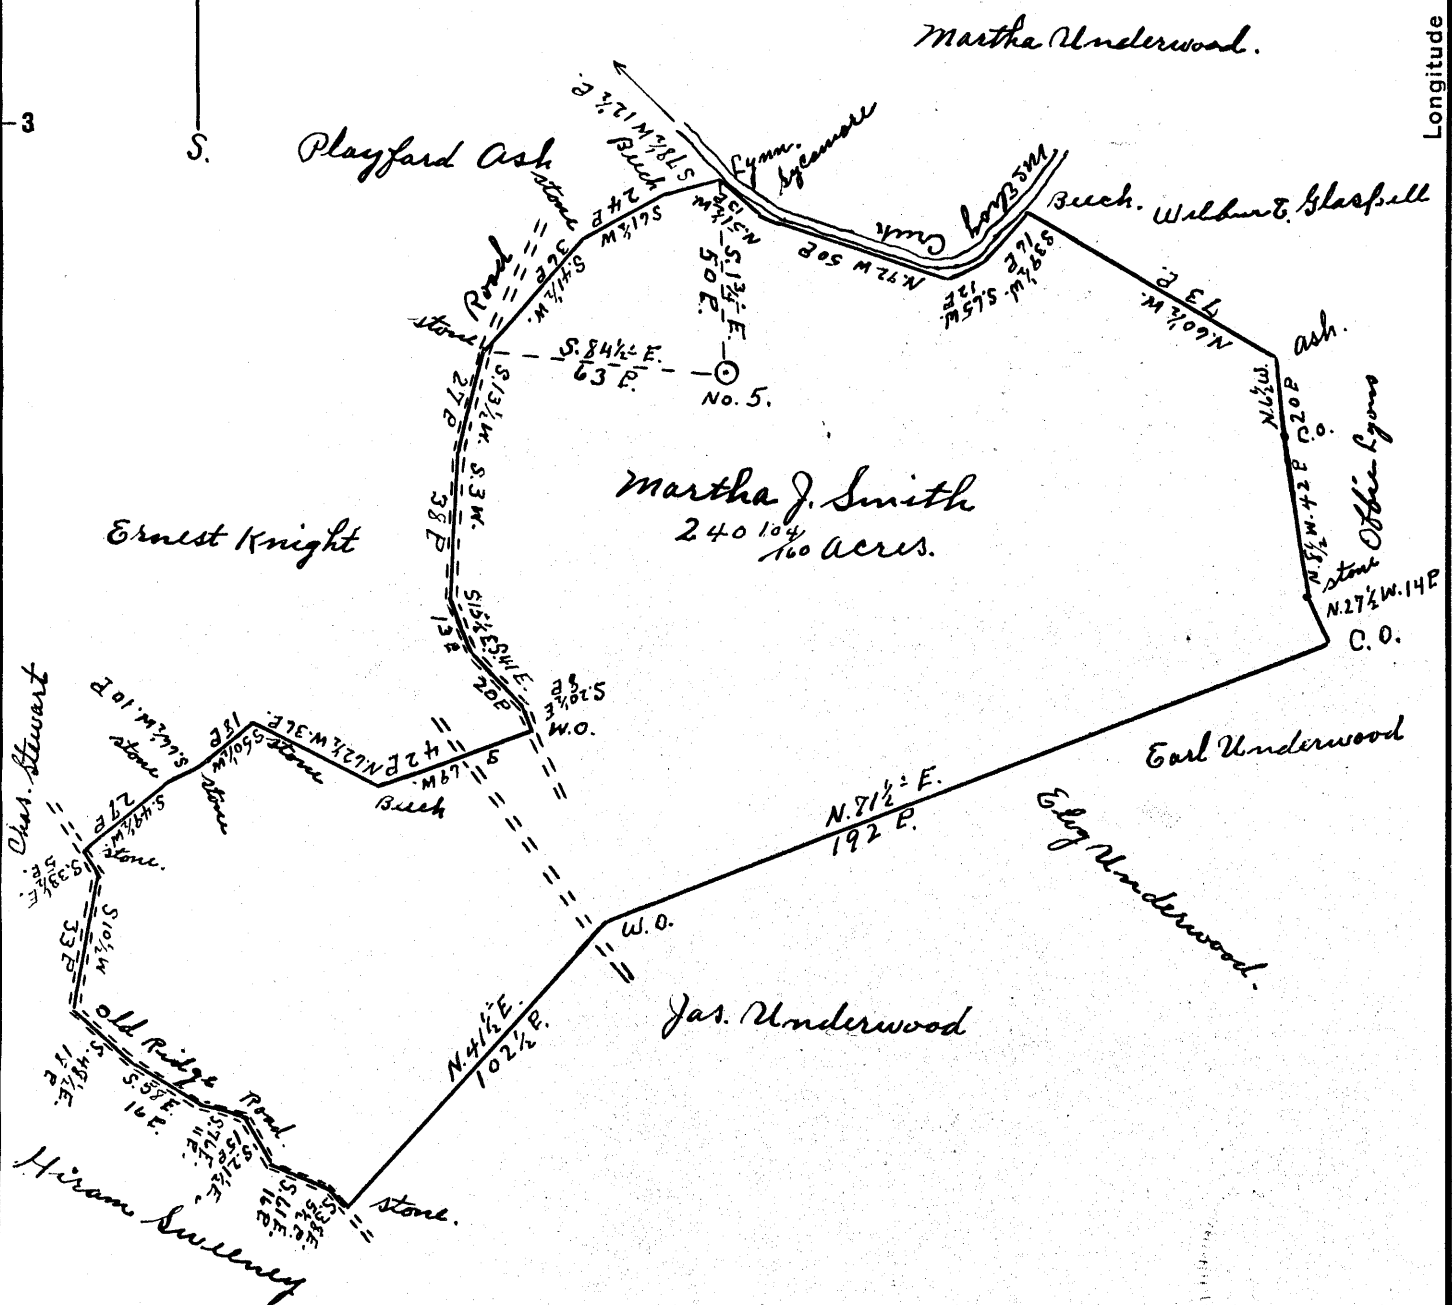

- New Location..
- Drill Deeper.....
- Abandonment.....

Company Mackey & White,
 Address Raven Rock, W.Va.
 Farm Martha J. Smith
 Tract _____ Acres 240 Lease No. _____
 Well (Farm) No. 5 Serial No. _____
 Elevation (Spirit Level) 961'
 Quadrangle Centerpoint
 County Doddridge District McClellan
 Engineer Robert R. Anderson
 By Ino Triplett, Surveyor
 Engineer's Registration No. 296
 File No. _____ Drawing No. _____
 Date July 8, 1956 Scale 1" = 50 P.

STATE OF WEST VIRGINIA
 DEPARTMENT OF MINES
 OIL AND GAS DIVISION
 CHARLESTON

WELL LOCATION MAP
 FILE NO. DOD-1069-A

+ Denotes location of well on United States Topographic Maps, scale 1 to 62,500, latitude and longitude lines being represented by border lines as shown.
 - Denotes one inch spaces on border line of original tracing.



1071

STATE OF WEST VIRGINIA
DEPARTMENT OF MINES
OIL AND GAS DIVISION

Quadrangle Center Point
Permit No. 1669A

WELL RECORD

Oil or Gas Well Oil
(KIND)

Company Greenwood Oil & Supply Company
Address West Union, W. Va.
Farm Martha J. Smith Acres 240
Location (waters) _____
Well No. 5 Elev. 961'
District McClellan County Doddridge
The surface of tract is owned in fee by Martha J. Smith,
Heirs Address Center Point, W. Va.
Mineral rights are owned by Same
Address _____
Drilling commenced 1899
Drilling completed 1899
Date Shot 6/3/99 From _____ To 2042' Injunc.
With 10 qts.
Open Flow /10ths Water in _____ Inch
/10ths Merc. in _____ Inch
Volume _____ Cu. Ft.
Rock Pressure _____ lbs. _____ hrs.
Oil _____ bbls., 1st 24 hrs.
WELL ACIDIZED _____
WELL FRACTURED _____

Casing and Tubing	Used in Drilling	Left in Well	Packers
Size			
16			Kind of Packer _____
13			
10	<u>4 1/4"</u>	<u>4 1/4"</u>	Size of _____
8 1/4	<u>1265'</u>	<u>None</u>	
6 5/8	<u>2047'</u>	<u>2047'</u>	Depth set _____
5 3/16			
3			Perf. top _____
2			Perf. bottom _____
Liners Used			Perf. top _____
			Perf. bottom _____

CASING CEMENTED _____ SIZE _____ No. Ft. _____ Date _____

COAL WAS ENCOUNTERED AT _____ FEET _____ INCHES
_____ FEET _____ INCHES _____ FEET _____ INCHES
_____ FEET _____ INCHES _____ FEET _____ INCHES

RESULT AFTER TREATMENT _____
ROCK PRESSURE AFTER TREATMENT _____
Fresh Water _____ Feet Salt Water _____ Feet

Formation	Color	Hard or Soft	Top	Bottom	Oil, Gas or Water	Depth	Remarks
No record available							
					C		

