


Latitude 39° 15'

Longitude 80° 45'

LEWIS MAXWELL
C-32A 2654⁸⁵

TOP LOC
+ 2.42 S
1.72 W

GW-75 No. 18A

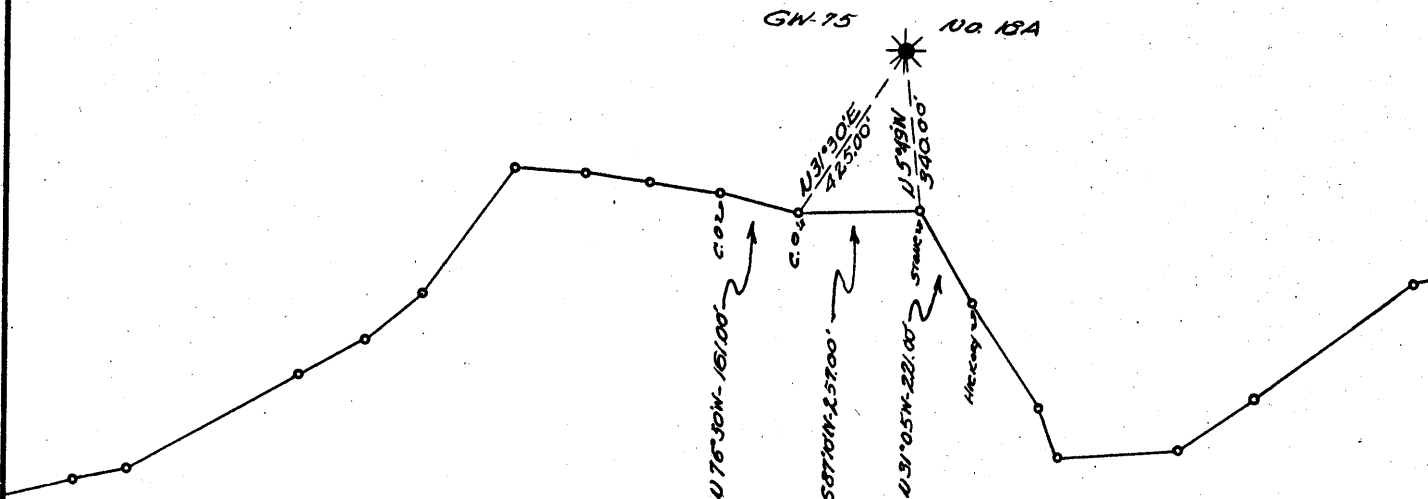

N. BRENT MAXWELL

- New Location ..
- Drill Deeper ..
- Abandonment ..

Company COLUMBIAN CARBON COMPANY
 Address Box 873 CHARLESTON, W.Va.
 Farm LEWIS MAXWELL
 Tract _____ Acres 2654 Lease No. C-32A
 Well (Farm) No. 18A Serial No. GW-75
 Elevation (Spirit Level) 1288.00'
 Quadrangle HOLBROOK-1 S248 W175
 County DODDRIDGE District WEST UNION
 Engineer R. B. Anderson
 Engineer's Registration No. 2074
 File No. _____ Drawing No. W-458
 Date 17 JUN 58 Scale 1"=400'

STATE OF WEST VIRGINIA
 DEPARTMENT OF MINES
 OIL AND GAS DIVISION
 CHARLESTON

WELL LOCATION MAP

FILE NO. DOD-1087-R

+ Denotes location of well on United States Topographic Maps, scale 1 to 62,500, latitude and longitude lines being represented by border lines as shown.

- Denotes one inch spaces on border line of original tracing.