

NOTE:- Tract shown and described is 210 acre portion of a 351 Acre lease:-  
 Surface:- Marshall Ash Hrs. Centerpoint, W. Va.  
 No coal mined in this vicinity.  
 Title to the coal, it is understood, is vested in the State of West Va.

New Location   
 Drill Deeper   
 Abandonment

Company **CARNEGIE NATURAL GAS CO.**  
 Address **Mannington, West Va.**  
 Farm **Marshall Ash**  
 Tract **Acres 351** Lease No. **8425**  
 Well (Farm) No. **2 and 5** Serial No. **5584762**  
 Elevation (Spirit Level) **No. 2: 825', No. 5 = 1133'**  
 Quadrangle **Centerpoint C**  
 County **Doddridge** District **McClellan**  
 Engineer **W. H. [Signature]**  
 Engineer's Registration No. **1227**  
 File No. \_\_\_\_\_ Drawing No. \_\_\_\_\_  
 Date **April, 1959** Scale **1" = 400' = 660'**

STATE OF WEST VIRGINIA  
 DEPARTMENT OF MINES  
 OIL AND GAS DIVISION  
 CHARLESTON

WELL LOCATION MAP  
 FILE NO. **DOD-1094-A #2-558**  
**DOD-1095-A #5-762**

+ Denotes location of well on United States Topographic Maps, scale 1 to 62,500, latitude and longitude lines being represented by border lines as shown.  
 - Denotes one inch spaces on border line of original tracing.



1039

STATE OF WEST VIRGINIA  
DEPARTMENT OF MINES  
OIL AND GAS DIVISION

Centerpoint Gdn

WELL RECORD

Permit No. 1045-A

Oil or Gas Well OIL  
(KIND)


Company Carnegie Natural Gas Company  
 Address 1015 Frick Building, Pittsburgh 19, Pa.  
 Farm Marshall Ash Acres 351  
 Location (waters) Broad Run  
 Well No. 5 - 762 Elev. 1133  
 District McClellan County Doddridge  
 The surface of tract is owned in fee by See Below  
 Address \_\_\_\_\_  
 Mineral rights are owned by See Below  
 Address \_\_\_\_\_  
 Drilling commenced 9-17-17  
 Drilling completed 10-23-17  
 Date Shot 6-25-20 From 2207 To 2213  
 With 15 quarts  
 Open Flow \_\_\_\_\_ /10ths Water in \_\_\_\_\_ Inch  
 \_\_\_\_\_ /10ths Merc. in \_\_\_\_\_ Inch  
 Volume \_\_\_\_\_ Cu. Ft.  
 Rock Pressure \_\_\_\_\_ lbs. \_\_\_\_\_ hrs.  
 Oil \_\_\_\_\_ bbls., 1st 24 hrs.  
 Fresh water \_\_\_\_\_ feet \_\_\_\_\_ feet  
 Salt water \_\_\_\_\_ feet \_\_\_\_\_ feet

Casing and Tubing	Used in Drilling	Left in Well	Packers
Size			
16			Kind of Packer
13			
10	193	None	Size of
8 1/4	1237	None	
6 1/2	2090	2090	Depth set
5 3/16			
3			Perf. top
2			Perf. bottom
Liners Used			Perf. top
			Perf. bottom

CASING CEMENTED \_\_\_\_\_ SIZE \_\_\_\_\_ No. Ft. \_\_\_\_\_ Date \_\_\_\_\_  
 COAL WAS ENCOUNTERED AT 793 FEET \_\_\_\_\_ INCHES  
 \_\_\_\_\_ FEET \_\_\_\_\_ INCHES FEET \_\_\_\_\_ INCHES  
 \_\_\_\_\_ FEET \_\_\_\_\_ INCHES FEET \_\_\_\_\_ INCHES

Formation	Color	Hard or Soft	Top	Bottom	Oil, Gas or Water	Depth Found	Remarks
Pittsburgh Coal			793	795			
Little Dunkard			1180	1190			
Big Dunkard			1235	1240			
Gas Sand			1530	1550			
First Salt Sand			1580	1650			
Second Salt Sand			1720	1740			
Maxon			1765	1790			
Little Lime			2030	2045			
Pencil Cave			2045	2055			
Big Lime			2055	2123			
Big Injun			2123				
					Gas	2127	
					Oil	2145	
					Gas	2163	
					Gas	2203	
					Oil	2210	
				2218			

SURFACE & MINERAL RIGHTS OWNERS  
 Fred M. Ash, Agent, Alma, W. Va.  
 Martha Ash & Martha Ash, Gdn. for Carl & Eva Ash, Center Point, W. Va.  
 O. E. Coffman, Shirley, W. Va.

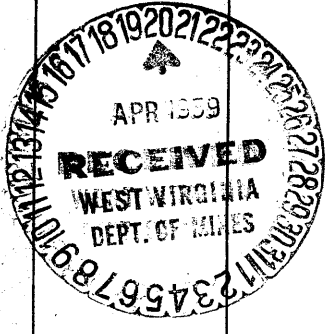

JUL 23 1939

