


Latitude 39° 20'

Longitude 80° 45'

0.20 S
0.20 W

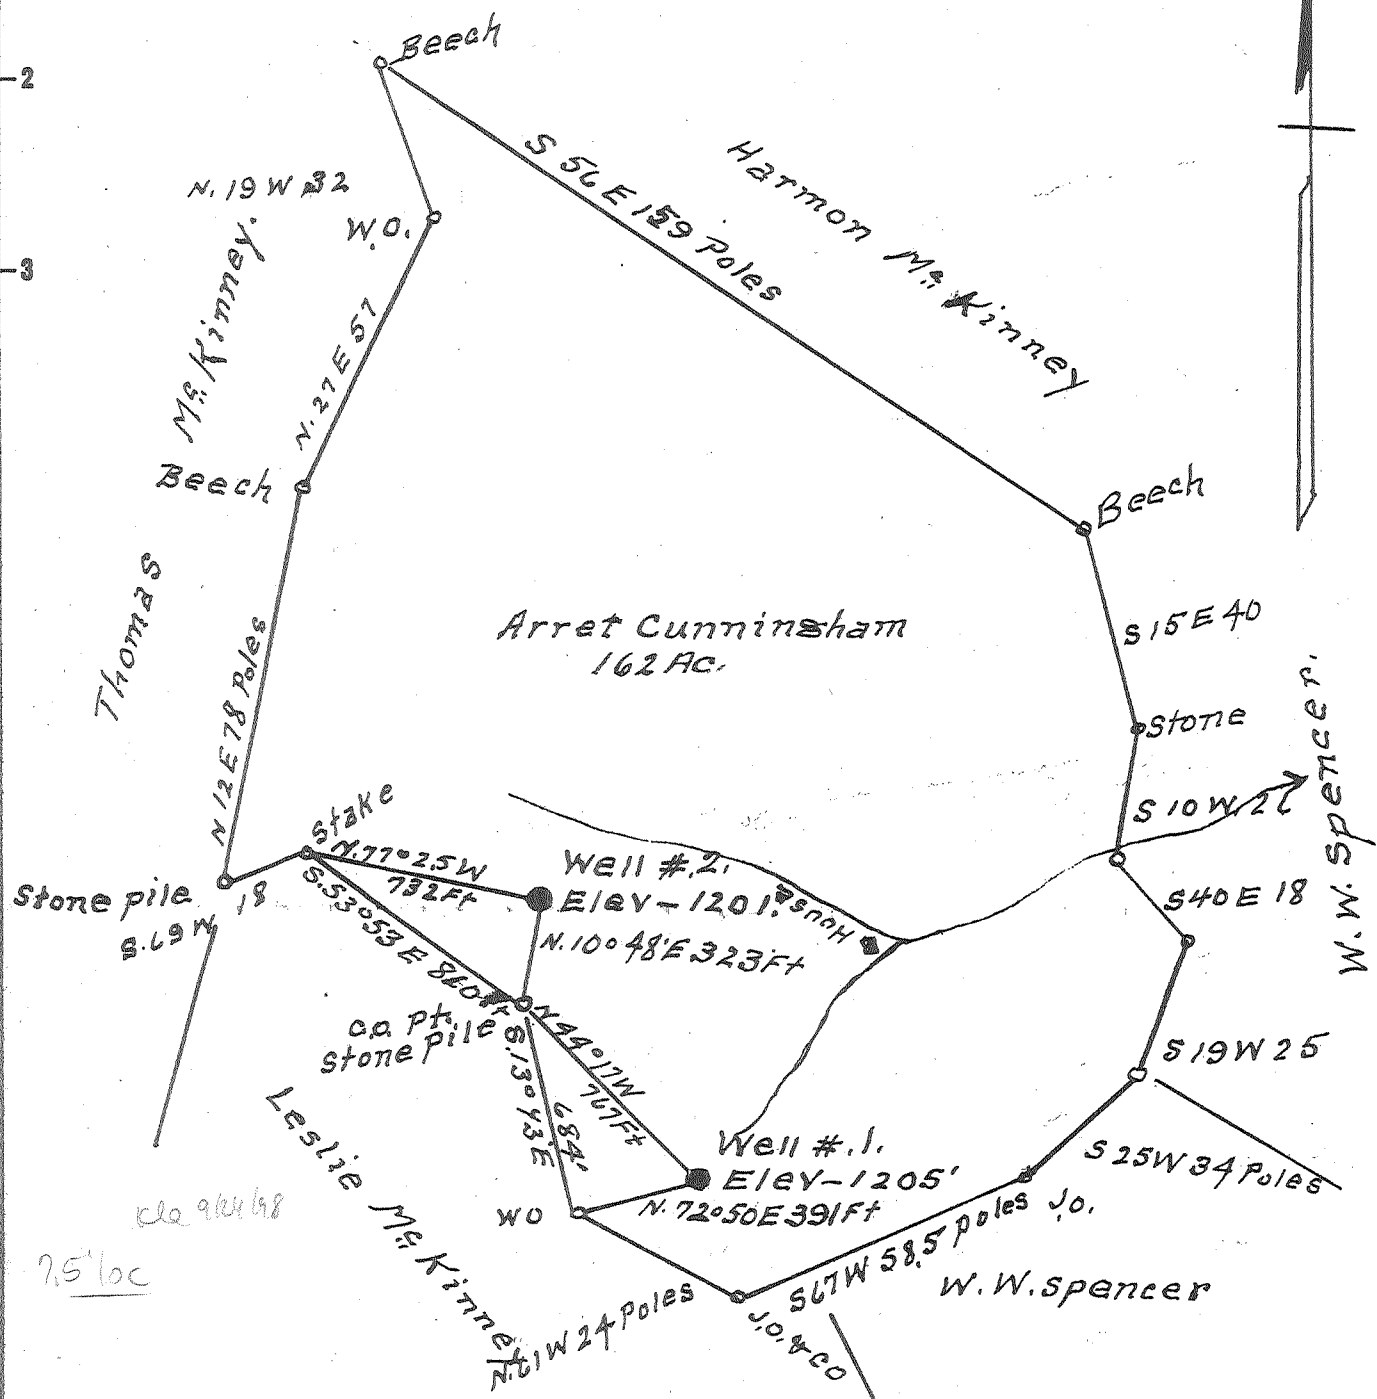

- New Location...
- Drill Deeper.....
- Abandonment.....

Company A. M. Snider
 Address Hundred W.U.
 Farm Arret Cunningham
 Tract 1 Acres 162 Lease No. _____
 Well (Farm) No. 2 Serial No. _____
 Elevation (Spirit Level) 1201'
 Quadrangle West Union SE
 County Doddridge District West Union
 Engineer A. L. Headley
 Engineer's Registration No. 2021
 File No. _____ Drawing No. _____
 Date 10-4-1957 Scale 1" = 600'

STATE OF WEST VIRGINIA
 DEPARTMENT OF MINES
 OIL AND GAS DIVISION
 CHARLESTON

WELL LOCATION MAP
 FILE NO. 000-1096-A

+ Denotes location of well on United States Topographic Maps, scale 1 to 62,500, latitude and longitude lines being represented by border lines as shown.

- Denotes one inch spaces on border line of original tracing.

0000-1096A



STATE OF WEST VIRGINIA
DEPARTMENT OF MINES
OIL AND GAS DIVISION

1040

Quadrangle West Union

Permit No. Ad-1096-A

WELL RECORD


Oil or Gas Well Oil
(KIND)

Company A. M. Snider
Address Hundred, W. Va.
Farm J. A. Smith Acres 162
Location (waters) _____
Well No. 2 Elev. 1201'
District West Union County Doddridge
The surface of tract is owned in fee by Arrett Cunningham
Address West Union, W. Va.
Mineral rights are owned by _____
Address _____
Drilling commenced _____
Drilling completed _____
Date Shot _____ From _____ To _____
With _____
Open Flow _____ /10ths Water in _____ Inch
_____ /10ths Merc. in _____ Inch
Volume _____ Cu. Ft.
Rock Pressure _____ lbs. _____ hrs.
Oil _____ bbls., 1st 24 hrs.
Fresh water _____ feet _____ feet
Salt water _____ feet _____ feet

Casing and Tubing	Used in Drilling	Left in Well	Packers
Size			
16			Kind of Packer
13			Size of
8 1/2			Depth set
6%	<u>2129</u>	<u>2129</u>	Perf. top
5 3/16			Perf. bottom
3			Perf. top
2			Perf. bottom
Liners Used			

CASING CEMENTED _____ SIZE _____ No. Ft. _____ Date _____
COAL WAS ENCOUNTERED AT _____ FEET _____ INCHES
_____ FEET _____ INCHES FEET _____ INCHES
_____ FEET _____ INCHES FEET _____ INCHES

Formation	Color	Hard or Soft	Top	Bottom	Oil, Gas or Water	Depth Found	Remarks
Pittsburgh Coal			578	581	(Circled)		
Cow run sand			1115	1155			
" " "			1380	1390			
Salt Sand			1550	1795			
Big Lime			2117	2197			
" Injun			2197	2316			
Gas			2161				
Oil			2288				
Total Depth			2319				

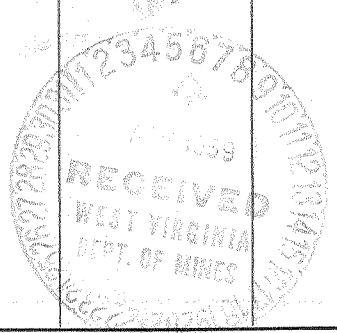

JUL 23 1959