

New Location
 Drill Deeper
 Abandonment

Formerly Hope Natural Gas Co. Well No. 7062

Company	LURAY LAND, INC.	
Address	POINT PLEASANT, WEST VA.	
Farm	L. S. FLEMING	
Tract	Acres 115	Lease No.
Well (Farm) No.	1	Serial No. 7062
Elevation (Spirit Level)	861'	
Quadrangle	HOLBROOK	
County	DODDRIDGE	District WEST UNION
Engineer	H. P. SUTER	
Engineer's Registration No.	1805	
File No.	Drawing No.	
Date 5 AUG. 1959	Scale 1" = 40 POLES	

STATE OF WEST VIRGINIA
 DEPARTMENT OF MINES
 OIL AND GAS DIVISION
 CHARLESTON

WELL LOCATION MAP
 FILE NO. DOD-1109-A

+ Denotes location of well on United States Topographic Maps, scale 1 to 62,500, latitude and longitude lines being represented by border lines as shown.

- Denotes one inch spaces on border line of original tracing.



1045

STATE OF WEST VIRGINIA
DEPARTMENT OF MINES
OIL AND GAS DIVISION

Quadrangle Halbrook
Permit No. 1109-A

WELL RECORD

Oil or Gas Well _____ (KIND)

Company Hope Natural Gas Company
Address Clarksburg, West Virginia
Farm L. S. Fleming Acres 115
Location (waters) _____
Well No. 7062 Elev. 861'
District West Union County Dodderidge
The surface of tract is owned in fee by _____
Address _____
Mineral rights are owned by _____
Address _____

Drilling commenced 11-7-1900
Drilling completed 1-19-1901
Date Shot 6-7-43 From Injun To 1107 to 1723'
With 1750 to 1745'

Open Flow _____ /10ths Water in _____ Inch
_____ /10ths Merc. in _____ Inch
Volume _____ Cu. Ft.
Rock Pressure _____ lbs. _____ hrs.
Oil _____ bbls., 1st 24 hrs.

WELL ACIDIZED _____
WELL FRACTURED _____

Casing and Tubing	Used in Drilling	Left in Well	Packers
Size			Kind of Packer
16			
13			
10	451	Pulled	Size of
8 1/4	850	Pulled	
6 5/8	1621	1621	Depth set
5 3/16	1152'S.L.	1630'	
3			Perf. top
2	2435	Pulled	Perf. bottom
Liners Used			Perf. top
			Perf. bottom


CASING CEMENTED _____ SIZE _____ No. Ft. _____ Date _____

COAL WAS ENCOUNTERED AT _____ FEET _____ INCHES
_____ FEET _____ INCHES _____ FEET _____ INCHES
_____ FEET _____ INCHES _____ FEET _____ INCHES

RESULT AFTER TREATMENT _____
ROCK PRESSURE AFTER TREATMENT _____
Fresh Water _____ Feet Salt Water _____ Feet

Formation	Color	Hard or Soft	Top	Bottom	Oil, Gas or Water	Depth	Remarks
Red Rock Cave			600	825			
Cow Run (First)			825	900	Oil at 837		
Salt Sand (Upper)			923	1023	Water 940		
Maxon			1558	1615			
Pencil Cave			1615	1620			
Big Lime			1620	1700	Gas 1632		
Injun Sand			1700	1766	Gas 1710		
Berea Sand			1875	1950			
Cave			2271	2301			
Gordon Stray			2301	2313			
Gordon Sand			2319	2327			
Total Depth Filled to			2445				
			1850'		6-23-43 - Injun Sand		

NOV 5 1959

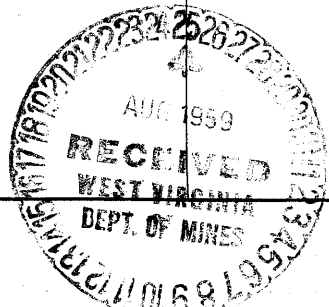

Formation	Color	Hard or Soft	Top	Bottom	Oil, Gas or Water	Depth Found	Remarks

Date May 29, 19 **59**

APPROVED LuRay Land, Inc., Owner

By Byron M. Finch
Byron M. Finch (Title) **Consultant** *ho*