

Surface: John Golden, Rt#1, Salem, W.Va.
 Coal: Mountaineer Coal Co., Box 1632, Fairmont, W.Va.

- New Location
- Drill Deeper
- Abandonment

Map N28 S13 E1

Company	<u>SOUTH PENN OIL CO.</u>
Address	<u>PARKERSBURG, W.Va.</u>
Farm	<u>Wm. VANSCOY</u>
Tract	Acres <u>35</u> Lease No. <u>32052</u>
Well (Farm) No.	<u>2</u> Serial No. _____
Elevation (Spirit Level)	<u>1180.26 cas. hd.</u>
Quadrangle	<u>CENTERPOINT</u>
County	<u>DODDRIDGE</u> District <u>GREENBRIER</u>
Engineer	<u>A.L. Kilbuck</u>
Engineer's Registration No.	<u>2534</u>
File No.	<u>1320</u> Drawing No. _____
Date	<u>APRIL 11, 1960</u> Scale <u>1" = 400'</u>

STATE OF WEST VIRGINIA
 DEPARTMENT OF MINES
 OIL AND GAS DIVISION
 CHARLESTON

WELL LOCATION MAP
 FILE NO. DoD-1143-A

+ Denotes location of well on United States Topographic Maps, scale 1 to 62,500, latitude and longitude lines being represented by border lines as shown.

- Denotes one inch spaces on border line of original tracing.



1089

STATE OF WEST VIRGINIA
DEPARTMENT OF MINES
OIL AND GAS DIVISION

Quadrangle Centerpoint

Permit No. 1143 A

WELL RECORD

Oil or Gas Well _____ (KIND)

Company SOUTH PENN OIL COMPANY
Address P. O. Box 1280 Parkersburg, W. Va.
Farm Wm. Vanscoy Acres 35
Location (waters) Fork of Galf Run
Well No. 2 Elev 1180.26
District Greenbrier County Doddridge
The surface of tract is owned in fee by John Golden
Rt. #1 Address Salem, W. Va.
Mineral rights are owned by G. L. Pezroy, et al
Address Salem, W. Va.

Casing and Tubing	Used in Drilling	Left in Well	Packers
Size			Kind of Packer
16			
13			
10	285	None	Size of
8 1/4	1480	None	
6 3/8	2280	2280	Depth set
5 3/16	2423	2423	
3			Perf. top
2			Perf. bottom
Liners Used			Perf. top
			Perf. bottom

Drilling commenced March 27, 1903
Drilling completed May 20, 1903
Date Shot 2 times From _____ To _____
With _____
Open Flow /10ths Water in _____ Inch
/10ths Merc. in _____ Inch
Volume _____ Cu. Ft.
Rock Pressure _____ lbs. _____ hrs.
Oil _____ bbls., 1st 24 hrs.
WELL ACIDIZED _____
WELL FRACTURED _____


CASING CEMENTED _____ SIZE _____ No. Ft. _____ Date _____

COAL WAS ENCOUNTERED AT 970 FEET 60 INCHES
_____ FEET _____ INCHES _____ FEET _____ INCHES
_____ FEET _____ INCHES _____ FEET _____ INCHES

RESULT AFTER TREATMENT _____
ROCK PRESSURE AFTER TREATMENT _____
Fresh Water _____ Feet Salt Water _____ Feet

Formation	Color	Hard or Soft	Top	Bottom	Oil, Gas or Water	Depth	Remarks
Pittsburgh Coal			970	975			
Dunkard Sand			1480	1535			
Gas Sand			1650	1765			
Salt Sand			1855	1898			
Big Injun Sand			2325	2420			
Stray Sand			3026	3040			
Gordon Sand			3062	3072			
					Gas & Oil	3027-3031	
					Oil Pay.	3065-3068	
TOTAL DEPTH				3087			

JUN 29 1960

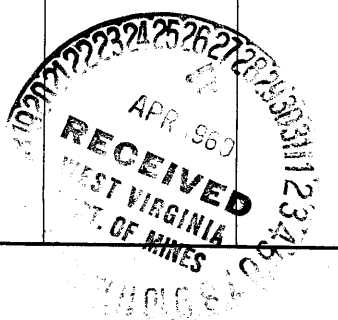

Formation	Color	Hard or Soft	Top	Bottom	Oil, Gas or Water	Depth Found	Remarks

Date April 25, 1960

APPROVED SOUTH PENN OIL COMPANY, Owner

By George W. Wilman
 (Title) Land Agent