

Company LURAY LAND, INC.
 Address POINT PLEASANT, WEST VA.
 Farm C. W. SLUSSER
 Tract _____ Acres 129 Lease No. _____
 Well (Farm) No. 1 Serial No. 7267
 Elevation (Spirit Level) 944'
 Quadrangle VADIS
 County DODDRIDGE District GREENBRIER
 Engineer Henry P. Suter
 Engineer's Registration No. 1805
 File No. _____ Drawing No. _____
 Date 6 FEB. 1961 Scale 1" = 40 POLES

STATE OF WEST VIRGINIA
 DEPARTMENT OF MINES
 OIL AND GAS DIVISION
 CHARLESTON

WELL LOCATION MAP
 FILE NO. DOD-1149-A
 was 017 70222, 70486, 71891

+ Denotes location of well on United States Topographic Maps, scale 1 to 62,500, latitude and longitude lines being represented by border lines as shown.

- Denotes one inch spaces on border line of original tracing.

.....District, Doddridge County, W. Va.
 By South Penn Oil Co.
 Completed, Dec. 23, 1891.
 Elevation, 965'.
 Obtained by M. R. Campbell.
 Authority, G. H. Dimmick.
 Record from U. S. Geological Survey, April 8, 1939.

70222 →

also

70486

nw 017

3149

	Thickness	Depth. to
Unknown		43
Coal	2 -	45
Unknown		300
Coal	10"	301
Unknown		430
Coal, large		...
Unknown		475
Sand, white		505
Unknown		580
Sand, black (?)		655
Unknown		900
Shale		930
Sand		980
Unknown		1265
Sand		1500
Limestone and shale		1580
Red rock		1705
Limestone, gray, hard		1765
Shale and sand		1800
Lime		1950
Slate		1985
Limestone		2300
Slate		2345
Shale and sandstone		2370
Sand		2400
Slate		2435
Big gas sand (pebbles)		2455



1101

STATE OF WEST VIRGINIA
DEPARTMENT OF MINES
OIL AND GAS DIVISION

Quadrangle Waldia
Permit No. 1149-A

WELL RECORD

Oil or Gas Well (KIND)

Company Hope Natural Gas Company
Address Clarksburg, W. Va.
Farm C. W. Slusser Acres _____

Location (waters) _____
Well No. 7267 Elev. 944'
District Greenbrier County Doddridge

The surface of tract is owned in fee by _____
Address _____

Mineral rights are owned by _____
Address _____

Drilling commenced July 27, 1891
Drilling completed Dec. 21, 1891

Date Shot 12/15/48 From Stray To _____

Volume before 13,345, Volume after 58,363

Open Flow _____ /10ths Water in _____ Inch
_____ /10ths Merc. in _____ Inch

Volume _____ Cu. Ft.
Rock Pressure _____ lbs. _____ hrs.
Oil _____ bbls., 1st 24 hrs.

WELL ACIDIZED _____
WELL FRACTURED _____

Casing and Tubing	Used in Drilling	Left in Well	Packers
Size			Kind of Packer
16			
13			
10	331'10"	331'10"	Size of <u>3x5-3/16"</u>
8 1/4	1025'5"	1025'5"	<u>6-5/8" 6-5/8x5-3/16"</u>
7 7	1754'	None	Depth set <u>1754'</u>
5 1/2 5 1/2	1816'	1816'	<u>1817'</u>
3	2452	None	Perf. top _____
2			Perf. bottom _____
Liners Used			Perf. top _____
			Perf. bottom _____

CASING CEMENTED 9" SIZE _____ No. Ft. _____ Date _____
12 Bags 1/14/49


COAL WAS ENCOUNTERED AT _____ FEET _____ INCHES
_____ FEET _____ INCHES
_____ FEET _____ INCHES

RESULT AFTER TREATMENT _____

ROCK PRESSURE AFTER TREATMENT _____

Fresh Water _____ Feet Salt Water _____ Feet

Formation	Color	Hard or Soft	Top	Bottom	Oil, Gas or Water	Depth	Remarks
Pittsburgh Coal			430	442	Water at 1480 Show of oil at 1845-55		
Dunkard Sand			930	980			
Salt Sand			1324	1500			
Injun Sand			1950	1985	Gas at 2435 Not Shown Gas at 2448		
Thirty Foot Sand			2370	2400			
Stray (Actually Gordon)			2435	2452			
Original Total Depth				2452			
Pocket Drilled to				2530			1/14/49

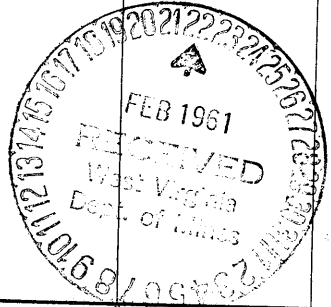

AUG 2 1961

(over)

C. W. SLUSSER No. 7267

Hope No. 6

DOD-1149-A

Formation	Color	Hard or Soft	Top	Bottom	Oil, Gas or Water	Depth Found	Remarks

Date January 31, 1961

APPROVED LuRay Land, Inc., Owner

By G. B. Pace *G. B. Pace*
(Title)