


Latitude 39° 25'



0.27S
3.32W

Longitude 80° 35'

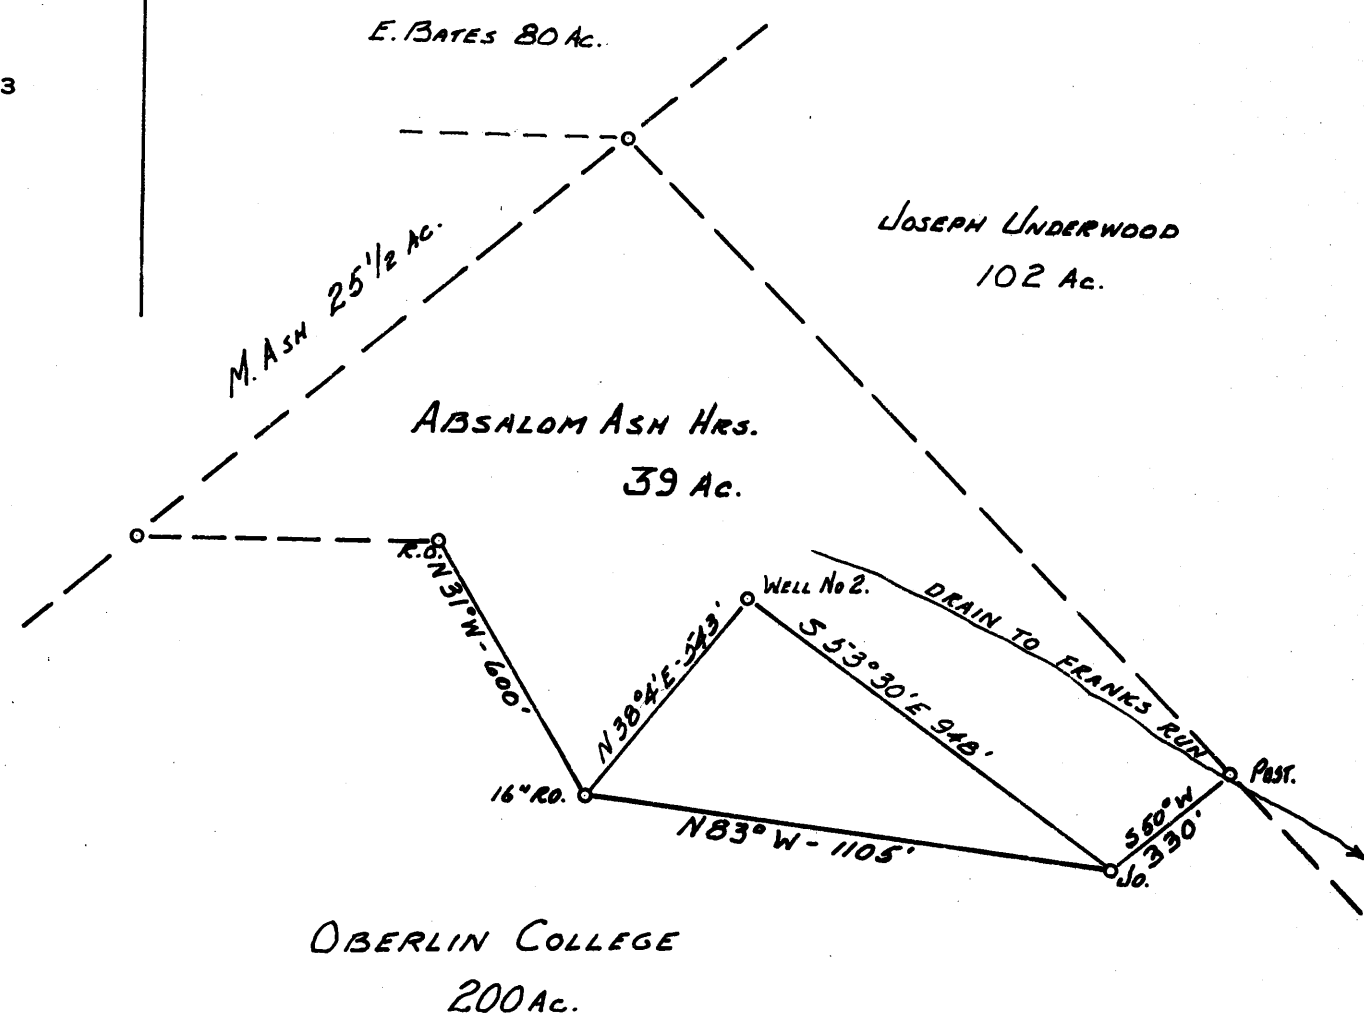

New Location
 Drill Deeper
 Abandonment

FORMER SOUTH PENN DILCO. LEASE NO. 15193

Company PACK & JACKSON
 Address Box 175. HAMLIN. W. VA.
 Farm ABSALOM ASH HRS.
 Tract _____ Acres 39 Lease No. _____
 Well (Farm) No. 2 Serial No. _____
 Elevation (Spirit Level) 1342.6'
 Quadrangle CENTERPOINT
 County DODDRIDGE District MCCLELLAN
 Engineer John W. Hamilton
 Engineer's Registration No. 2274
 File No. _____ Drawing No. _____
 Date MAR 22, 1962 Scale 1" = 400'

STATE OF WEST VIRGINIA
 DEPARTMENT OF MINES
 OIL AND GAS DIVISION
 CHARLESTON

WELL LOCATION MAP
 FILE NO. DOD-1164-R

+ Denotes location of well on United States Topographic Maps, scale 1 to 62,500, latitude and longitude lines being represented by border lines as shown.

- Denotes one inch spaces on border line of original tracing.