


-0 1 2 3 LATITUDE 39 ° 20 1

-1  
-2  
-3

LONGITUDE 80 ° 35'

0.815  
0.34W

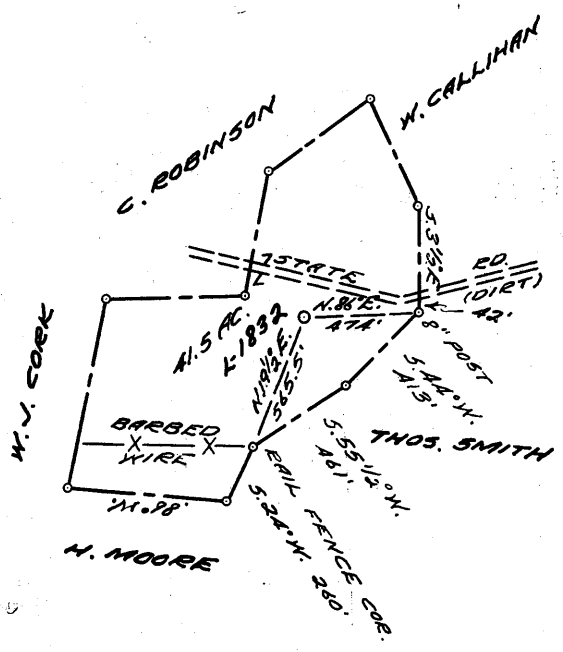

COAL OWNED BY \_\_\_\_\_

NEW LOCATION.....

DRILL DEEPER.....

ABANDONMENT.....

Q-25-24

COMPANY THE MANUFACTURERS LIGHT & HEAT

ADDRESS 800 UNION TRUST BLDG., PGH. PA.

FARM N. AND R. UNDERWOOD

TRACT \_\_\_\_\_ ACRES 41.50 LEASE NO. L-5184

WELL (FARM) NO. 1 SERIAL NO. 1832

ELEVATION (SPIRIT LEVEL) 1036'

QUADRANGLE CENTERPOINT

COUNTY DODDRIDGE DISTRICT MC CLELLAN

ENGINEER Robert M. Heill (J.P.C.)

ENGINEER'S REGISTRATION NO. 361-E

FILE NO. \_\_\_\_\_ DRAWING NO. Y-25-592

DATE 2 JULY 62 SCALE 1" = 800'

STATE OF WEST VIRGINIA  
DEPARTMENT OF MINES  
OIL AND GAS DIVISION  
CHARLESTON

**WELL LOCATION MAP**

FILE No. DOD-1170-A

+ DENOTES LOCATION OF WELL ON UNITED STATES TOPOGRAPHIC MAPS. SCALE 1 TO 62,500. LATITUDE AND LONGITUDE LINES BEING REPRESENTED BY BORDER LINES AS SHOWN.

- DENOTES ONE INCH SPACES ON BORDER LINE OF ORIGINAL TRACING.