


Latitude 39° 15' 1"

Longitude 80° 30' 1"

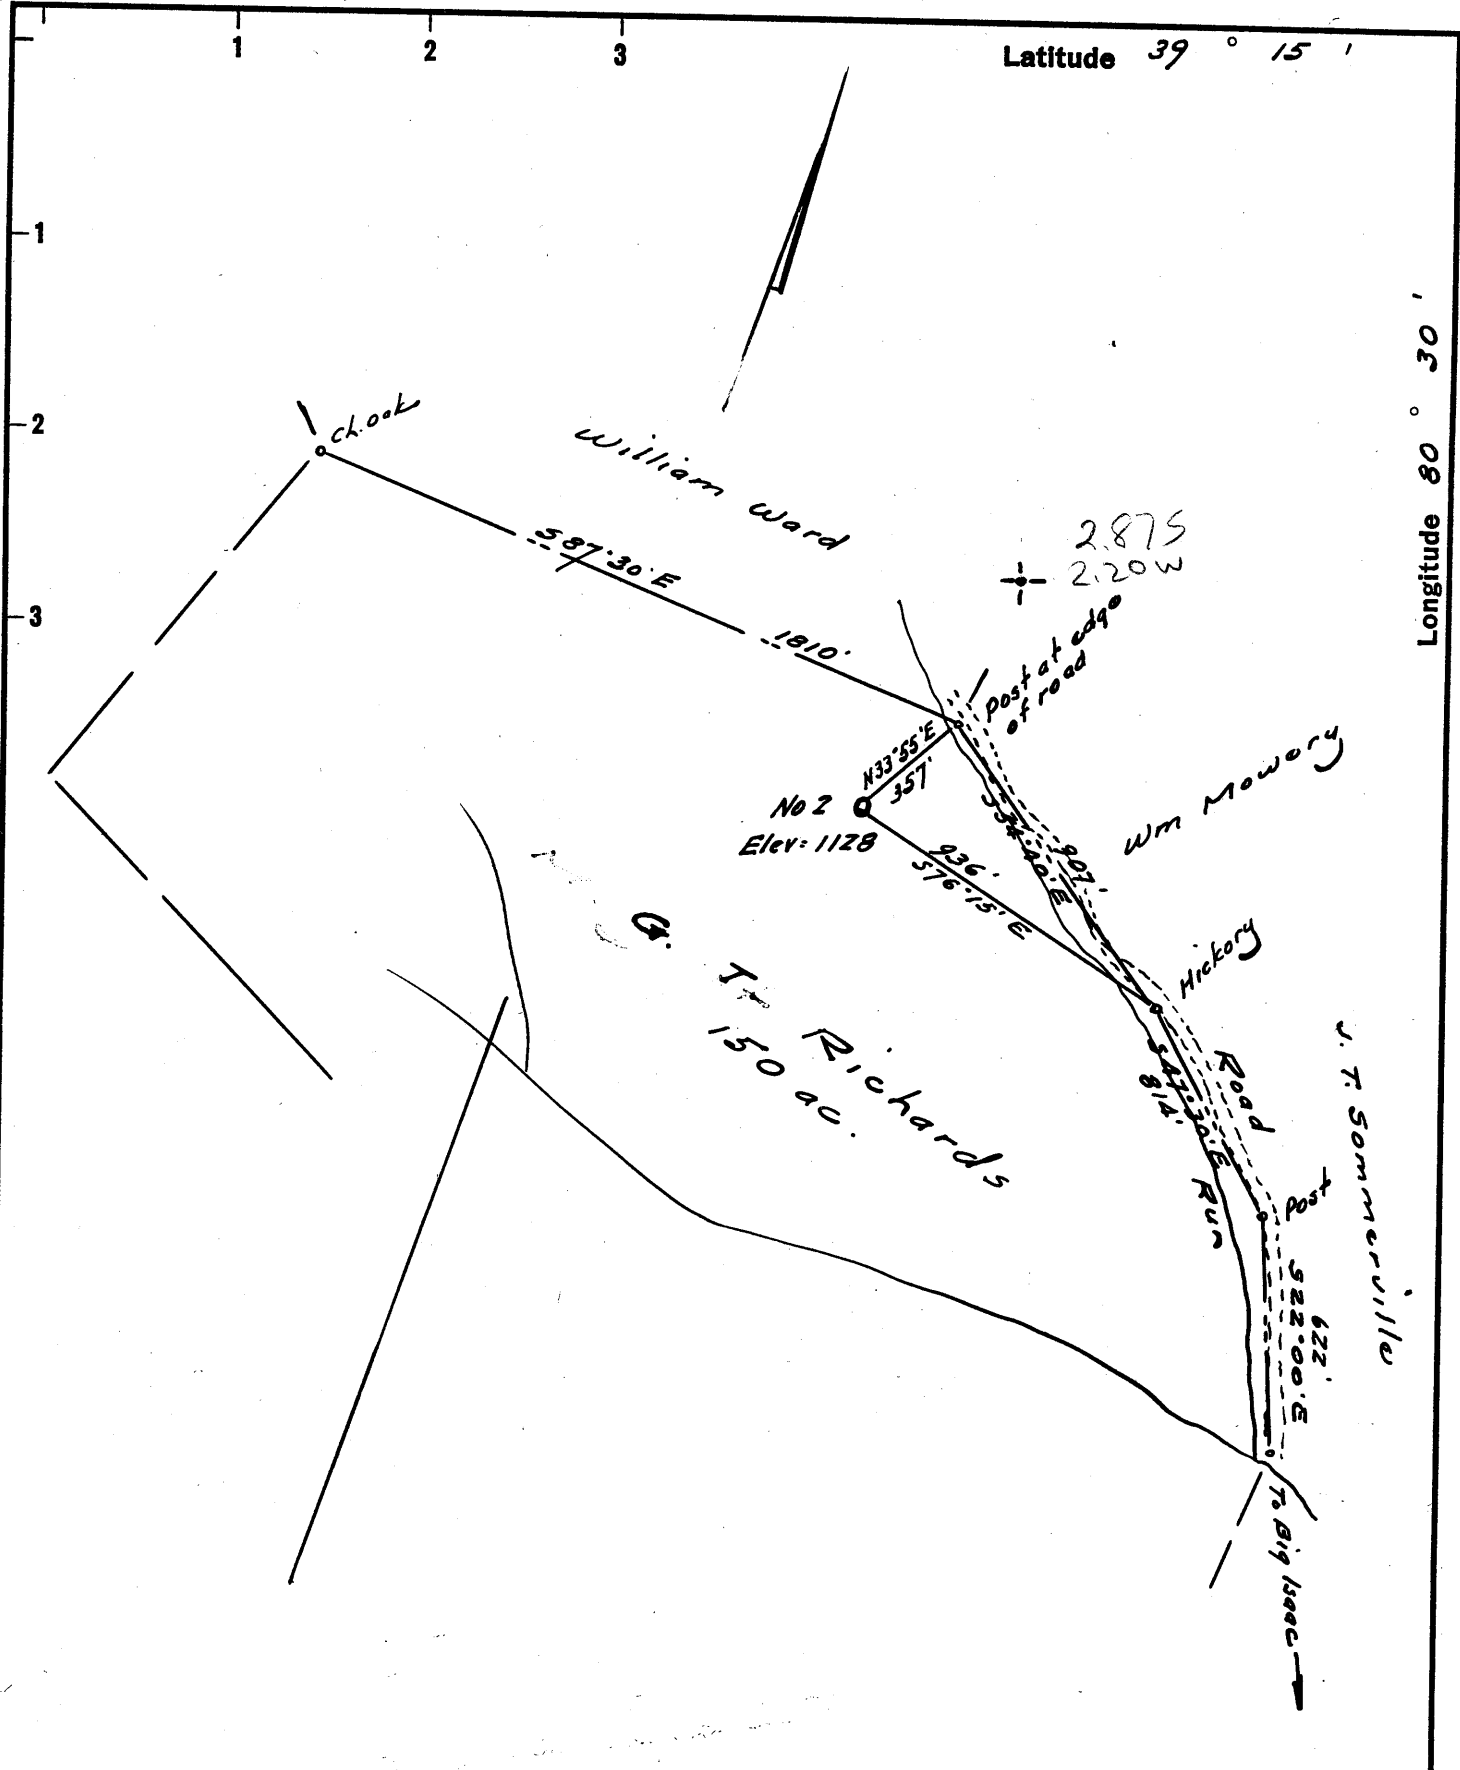

New Location
 Drill Deeper
 Abandonment

Company WILLIAM CASSADY
 Address 4303 Whitford Drive, Vienna, West Va.
 Farm G. T. Richards
 Tract _____ Acres 150 Lease No. _____
 Well (Farm) No. Two Serial No. _____
 Elevation (Spirit Level) 1128
 Quadrangle Vadis
 County Doddridge District Greenbrier
 Engineer W. H. Abel
 Engineer's Registration No. 1227
 File No. _____ Drawing No. _____
 Date Nov. 2, 1962 Scale 1" = 500'

STATE OF WEST VIRGINIA
 DEPARTMENT OF MINES
 OIL AND GAS DIVISION
 CHARLESTON

WELL LOCATION MAP
 FILE NO. Dod-1173-A

+ Denotes location of well on United States Topographic Maps, scale 1 to 62,500, latitude and longitude lines being represented by border lines as shown.
 - Denotes one inch spaces on border line of original tracing.