


23,250'

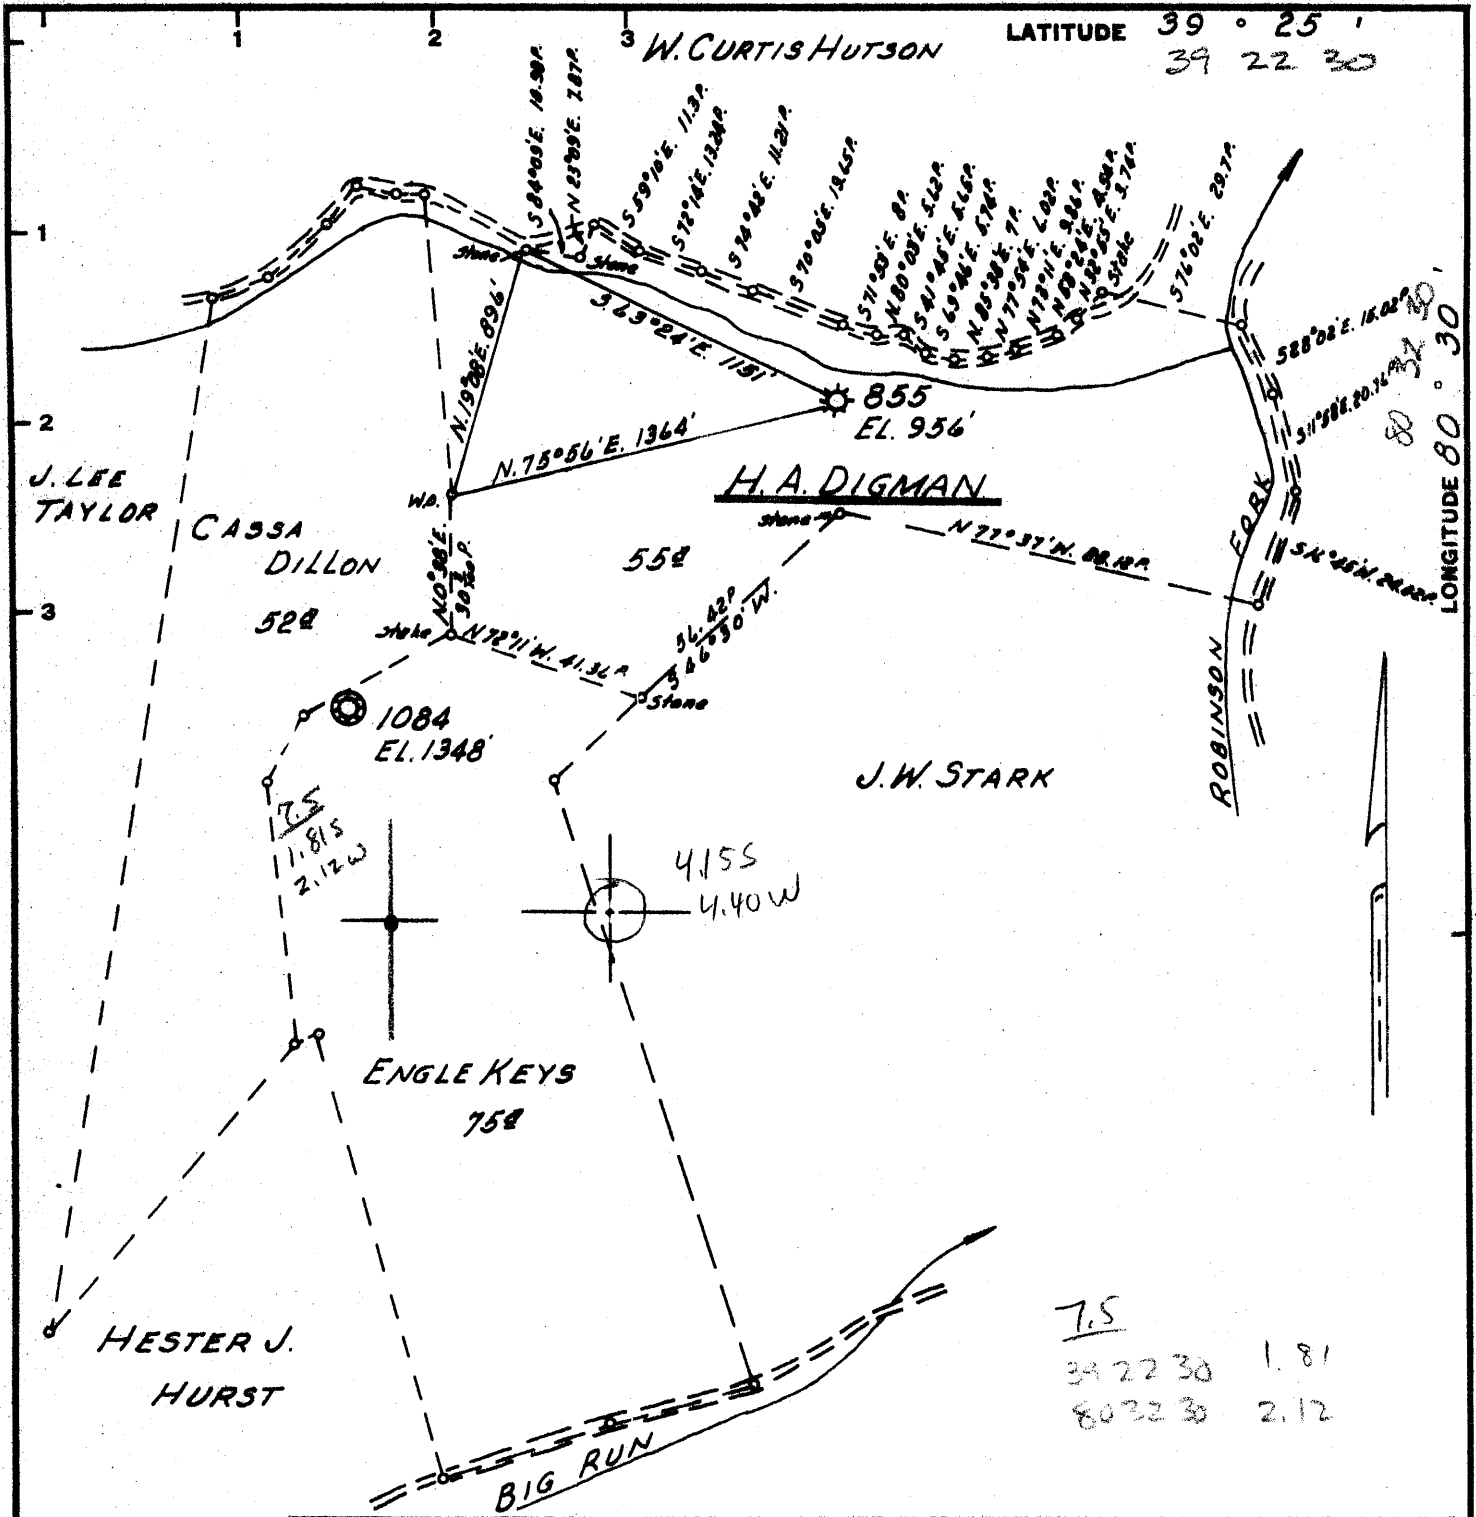

7.5
39 22 30 1.81
80 32 30 2.12

New Location
 Drill Deeper
 Abandonment

10-2-67 MAPSHT. 45-57E2, F.B. 548 P. 23-24

Company CONSOLIDATED GAS SUPPLY CORP.
 Address CLARKSBURG, W. VA.
 Farm H. A. DIGMAN
 Tract _____ Acres 55 Lease No. 3445
 Well (Farm) No. _____ Serial No. 855
 Elevation (Spirit Level) 956'
 Quadrangle CENTERPOINT E.C.
 County DODDRIDGE District MCGLELLAN
 Engineer Jackson M. Jarvis
 Engineer's Registration No. 2397
 File No. _____ Drawing No. _____
 Date AUG. 25, 1966 Scale 1" = 40 POLES

STATE OF WEST VIRGINIA
 DEPARTMENT OF MINES
 OIL AND GAS DIVISION
 CHARLESTON

WELL LOCATION MAP
 FILE NO. DOD-1202-A
 72307 on CNG maps

+ Denotes location of well on United States Topographic Maps, scale 1 to 62,500, latitude and longitude lines being represented by border lines as shown.

- Denotes one inch spaces on border line of original tracing.

OCT 10 1967