


LATITUDE 39°20'

80°12'30"

LONGITUDE

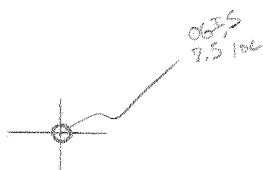

7'5 OGIS topo location

7.5' loc	<u>2.55 S</u>	15' loc	<u>2.55 S</u>
	<u>1.88 W</u>	(calc.)	<u>4.11 W</u>

Company Bridgeport Natural Gas Co.

Farm Jesse H Willis

Quad Rosemont Fairmont SW

County Harrison

District Simpson #

WELL LOCATION MAP

File No. 033-2

Simpson District, Harrison County, W. Va.

By Bridgeport Natural Gas & Oil Co., Bridgeport, W. Va. (D. H. Gawthrop, Secy.)

On 250 acres, surface owned by J. C. Lawson, Bridgeport, W. Va.,
and $\frac{1}{2}$ mineral rights by Dr. C. A. Willis, Charleston, W. Va.,
and W. W. Willis, Bridgeport, W. Va.

Drilled under permit issued Aug. 9, 1929. (Harr-2?)

Elevation, 994.7' E.

14" conductor, 16'; 10" casing, 127'; 8 $\frac{1}{2}$ ", 700'; 6-5/8", 1160'.

One packer, 6-5/8, set at 1160'; one packer, 6 $\frac{1}{2}$ x 2, set at 1183'.

2" tubing perforated at 1130-1140'.

Coal was encountered at 490-492'. No liner used.

Well finished on September 16, 1929.

40/10 water in 2" when tubed. Gas well.

All casing left in well.

Well was not shot.

Fresh water at 85'; salt water at 167'.

	Top.	Bottom.	Thickness.
Little Dunkard Sand, light, soft (water)	85	110	25
Big Dunkard Sand, light, soft (water)	167	245	78
Sand, light, hard	280	320	40
Salt Sand, dark, hard	360	490	130
Coal, dark, soft	490	492	2
Sand, light, hard	492	698	206
Slate and shells, dark, hard	698	830	132
Red rock, soft	830	1118	288
Little Line, dark, hard	1118	1130	12
Pencil Cave, dark, soft	1130	1138	8
Big Line, light, hard	1138	1211	73
Big Injun Sand, light, hard (gas at 1214')	1211	1316	105
Slate and shells, dark, hard	1316	1664	348
Fifty-foot Sand, dark, hard	1664	1723	59
Thirty-foot Sand, light, hard	1725	1885	160
Red rock, soft	1885	2015	130
Sand, dark, soft	2015	2035	20
Fourth Sand, dark, hard	2050	2092	42
Fifth Sand, dark, hard (gas, 2225- 2232'; 40/10 W. in 2" when tubed)	2191	2237	46
Total depth		2282	

267 MCF

COMPLETION DATA SHEET NO. 2

Har-2


FORMATION RECORD

NAME	COLOR	CHARACTER	OIL, GAS OR WATER	TOP	BOTTOM	THICK-NESS	TOTAL DEPTH	REMARKS
Little Dunk.	Light	Soft	Water	85	110	25		
Big Dunkard	Light	Soft	Water	167	245	78		
and	Light	Hard		280	320	40		
Salt Sand	Dark	Hard		360	490	130		
Coal	Dark	Soft		490	492	2		
and	Light	Hard		492	698	206		
Plate & Shells	Dark	Hard		698	830	132		
Red Rock	Red	Soft		830	1118	288		
Little Lime	Dark	Hard		1118	1130	12		
Pencil Cave	Dark	Soft		1130	1138	8		
Big Lime	Light	Hard		1138	1211	73		
Big Injin	Light	Hard		1211	1316	105		Gas at 1214
Plate & Shells	Dark	Hard		1316	1664	348		
Fifty Foot	Dark	Hard		1664	1723	59		
Dirty Foot	Light	Hard		1725	1885	160		
Red Rock	Red	Soft		1885	2015	130		
and	Dark	Soft		2015	2035	20		
and 4th.	Dark	Hard		2050	2092	42		
and 5th.	Dark	Hard		2191	2237	46		Gas 2225 to 2232
BOTTOM							2282	40/10 water in 2" when tubed. All Casing was left in well.

~~XXXX~~
Well was not shot at _____ feet; well was shot at _____ feet.

~~XXXX~~ Salt
Fresh water at 85 feet; ~~XXXX~~ water at 167 feet.

producing
Well was ~~XXXX~~ hole.

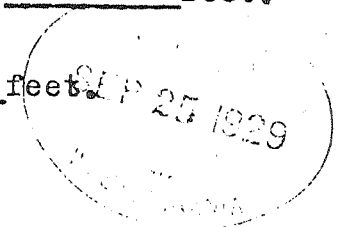

September 16th 1929 Date Approved Bridgeport Natural Gas & Oil Co, Owner

NOTE: All bottom formations must be noted as indicated above and all key-rocks and oil and gas sands must be recorded under their proper geological names in the district as well as any local names for which strata that may be common to the district.

Har-2
6