

WW-7
8-30-06



West Virginia Department of Environmental Protection
Office of Oil and Gas
WELL LOCATION FORM: GPS

API: 47-033-00034 WELL NO.: 1
 FARM NAME: Lancaster, Frank
 RESPONSIBLE PARTY NAME: XTO Energy INC.
 COUNTY: Harrison DISTRICT: Sardis
 QUADRANGLE: Wolf Summit, WV
 SURFACE OWNER: Meredith Cheryl Lynn & William John
 ROYALTY OWNER: See Attached
 UTM GPS NORTHING: 4356505.5 meters
 UTM GPS EASTING: 551152.3 meters GPS ELEVATION: 1088'

The Responsible Party named above has chosen to submit GPS coordinates in lieu of preparing a new well location plat for a plugging permit or assigned API number on the above well. The Office of Oil and Gas will not accept GPS coordinates that do not meet the following requirements:

1. Datum: NAD 1983, Zone: 17 North, Coordinate Units: meters, Altitude: height above mean sea level (MSL) – meters.
2. Accuracy to Datum – 3.05 meters
3. Data Collection Method:

Survey grade GPS : Post Processed Differential

Real-Time Differential

Mapping Grade GPS : Post Processed Differential

Real-Time Differential

4. Letter size copy of the topography map showing the well location.


I the undersigned, hereby certify this data is correct to the best of my knowledge and belief and shows all the information required by law and the regulations issued and prescribed by the Office of Oil and Gas.

B. C. [Signature] Project Manager 8-18-17
 Signature Title Date

09/22/2017
RECEIVED
Office of Oil and Gas

SEP - 5 2017

WV Department of
Environmental Protection

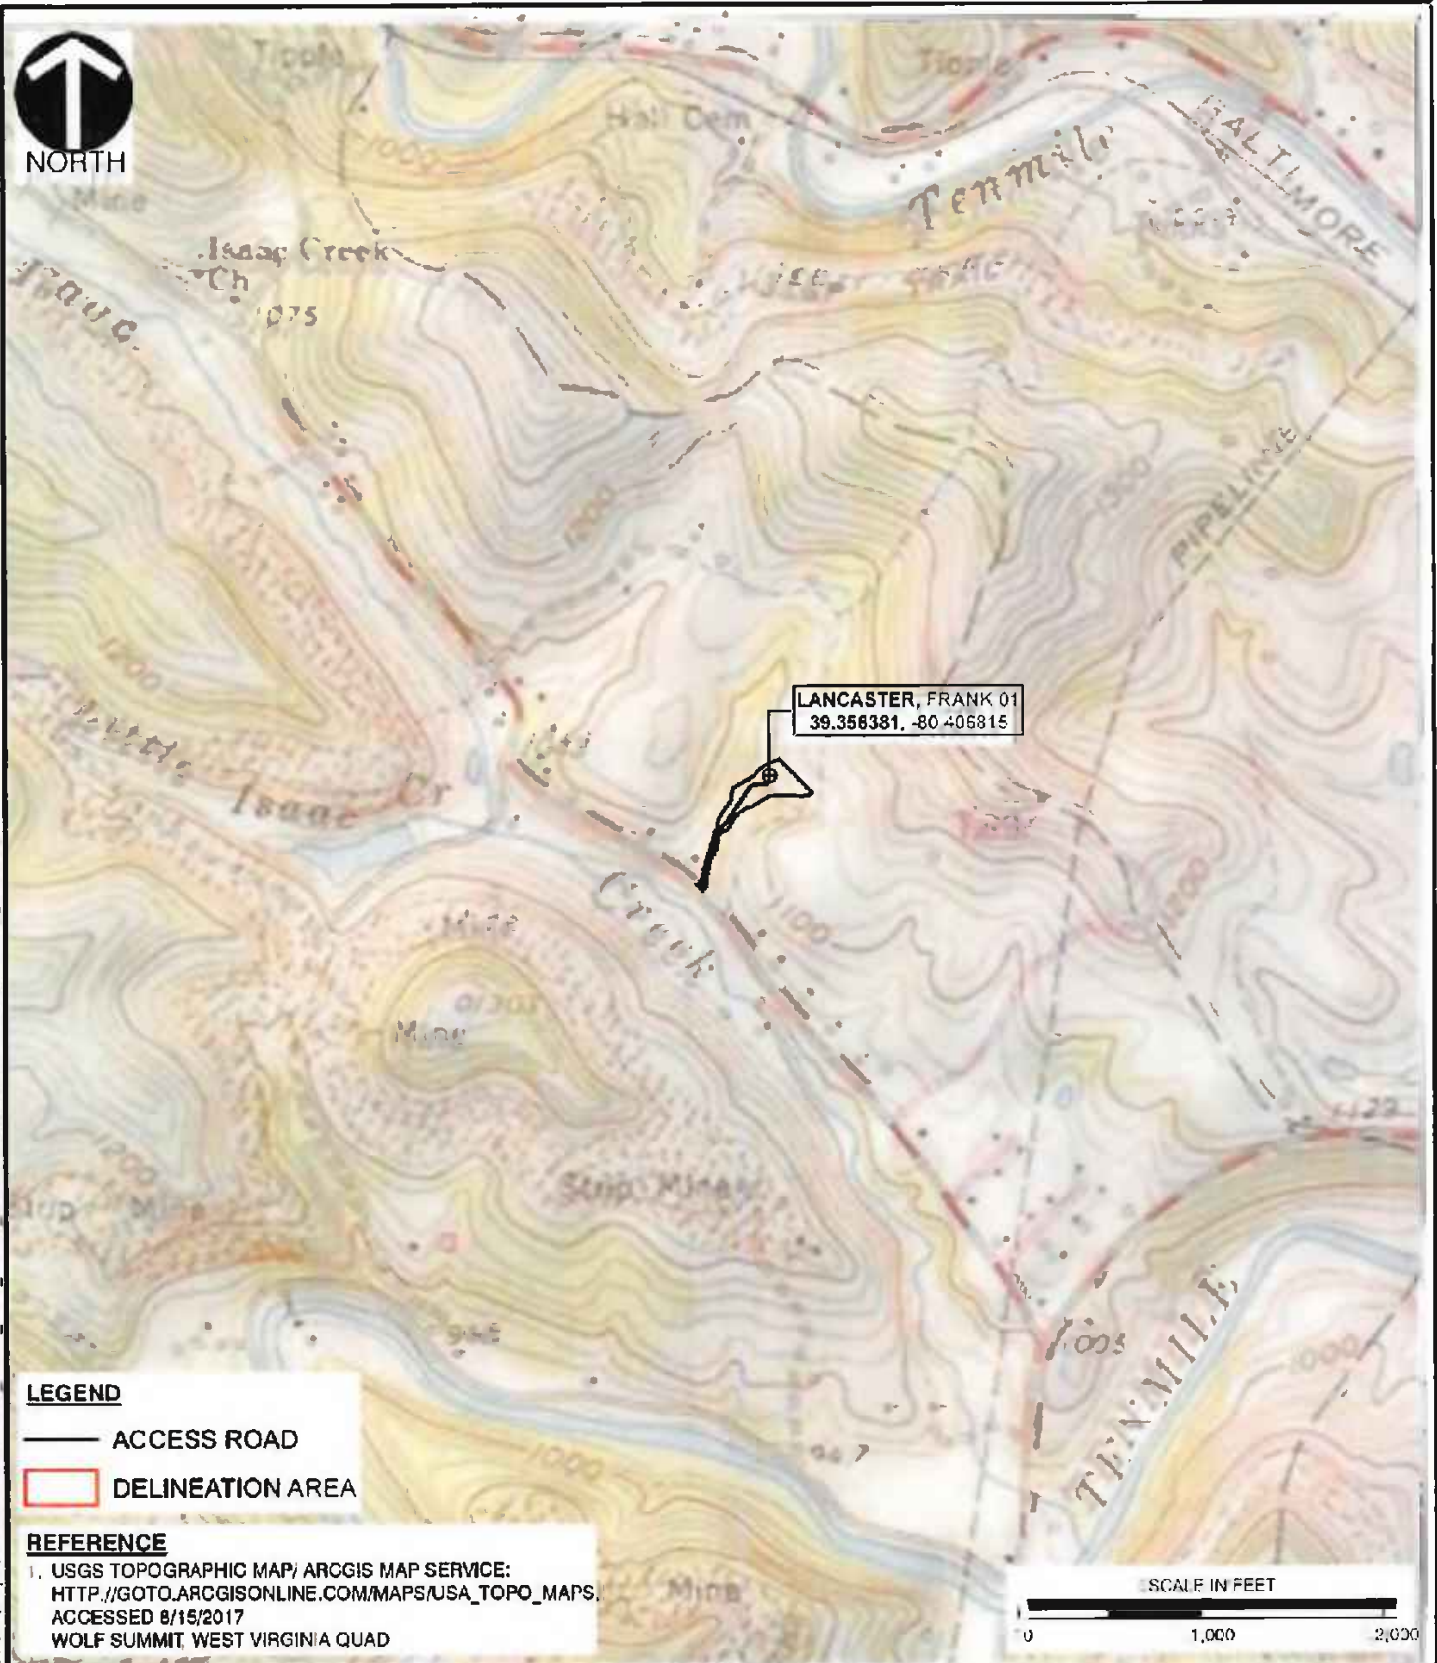

LEGEND
 — ACCESS ROAD
 □ DELINEATION AREA

REFERENCE
 1. USGS TOPOGRAPHIC MAP/ ARCGIS MAP SERVICE:
[HTTP://GTO.ARCGISONLINE.COM/MAPS/USA_TOPO_MAPS](http://gto.arcgis.com/maps/usa_topo_maps),
 ACCESSED 8/15/2017
 WOLF SUMMIT WEST VIRGINIA QUAD

I:\sv-pittsburgh\proj\172-990-GIS\Map\AW00\WDSIR_172990_AW00_FIG1_WDSIR_SITE.mxd 8/15/2017 10:10:35 AM (gkuckuck)



Civil & Environmental Consultants, Inc.
 600 Marketplace Avenue, Suite 200 - Bridgeport, WV 26330-9121
 Ph: 304-933-3119 • Toll: 855-488-9539 • Fax: 304-933-3327
 www.cecinc.com

XTO ENERGY, INC.
LANCASTER, FRANK 01 WELL PLUGGING
HARRISON COUNTY, WEST VIRGINIA

USGS SITE LOCATION MAP

DRAWN BY: GSK	CHECKED BY: KAD	APPROVED BY: ^{Hand signature on file} JDK*	FIGURE NO: 1
DATE: 08/15/2017	SCALE: 1" = 1,000'	PROJECT NO: 172-990.AW00	09/22/2017

RECEIVED
 Office of Oil and Gas
 SEP - 5 2017
 WV Department of
 Environmental Protection