

WW-7
8-30-06



West Virginia Department of Environmental Protection
Office of Oil and Gas
WELL LOCATION FORM: GPS

API: 47-033-00359 WELL NO.: WV 151281 (John W. McKinley #8184)

FARM NAME: John W. McKinley

RESPONSIBLE PARTY NAME: EQT Production Company

COUNTY: Harrison DISTRICT: Union

QUADRANGLE: West Milford 7.5'

SURFACE OWNER: Jan Marie Ashcraft

ROYALTY OWNER: Misha Denham, et al.

UTM GPS NORTHING: 4341154

UTM GPS EASTING: 548328 GPS ELEVATION: 331 m (1086 ft)

The Responsible Party named above has chosen to submit GPS coordinates in lieu of preparing a new well location plat for a plugging permit or assigned API number on the above well. The Office of Oil and Gas will not accept GPS coordinates that do not meet the following requirements:

1. Datum: NAD 1983, Zone: 17 North, Coordinate Units: meters, Altitude: height above mean sea level (MSL) – meters.
2. Accuracy to Datum – 3.05 meters
3. Data Collection Method:

Survey Grade GPS _____ : Post Processed Differential _____
 Real-Time Differential _____
 Mapping Grade GPS X : Post Processed Differential X
 Real-Time Differential _____

4. **Letter size copy of the topography map showing the well location.**

I the undersigned, hereby certify this data is correct to the best of my knowledge and belief and shows all the information required by law and the regulations issued and prescribed by the Office of Oil and Gas.

Signature

PS #2180
Title

9/10/18
Date

RECEIVED
Office of Oil and Gas

SEP 26 2018

WV Department of
Environmental Protection

10/12/2018

Topo Quad: West Milford 7.5'

Scale: 1" = 2000'

Office of Oil and Gas

County: Harrison

Date: September 10, 2018

SEP 26 2018


District: Union

Project No: 70-36-00-08

WV Department of Environmental Protection

47-033-00359 WV 151281 (John W. McKinley #8184)

Topo

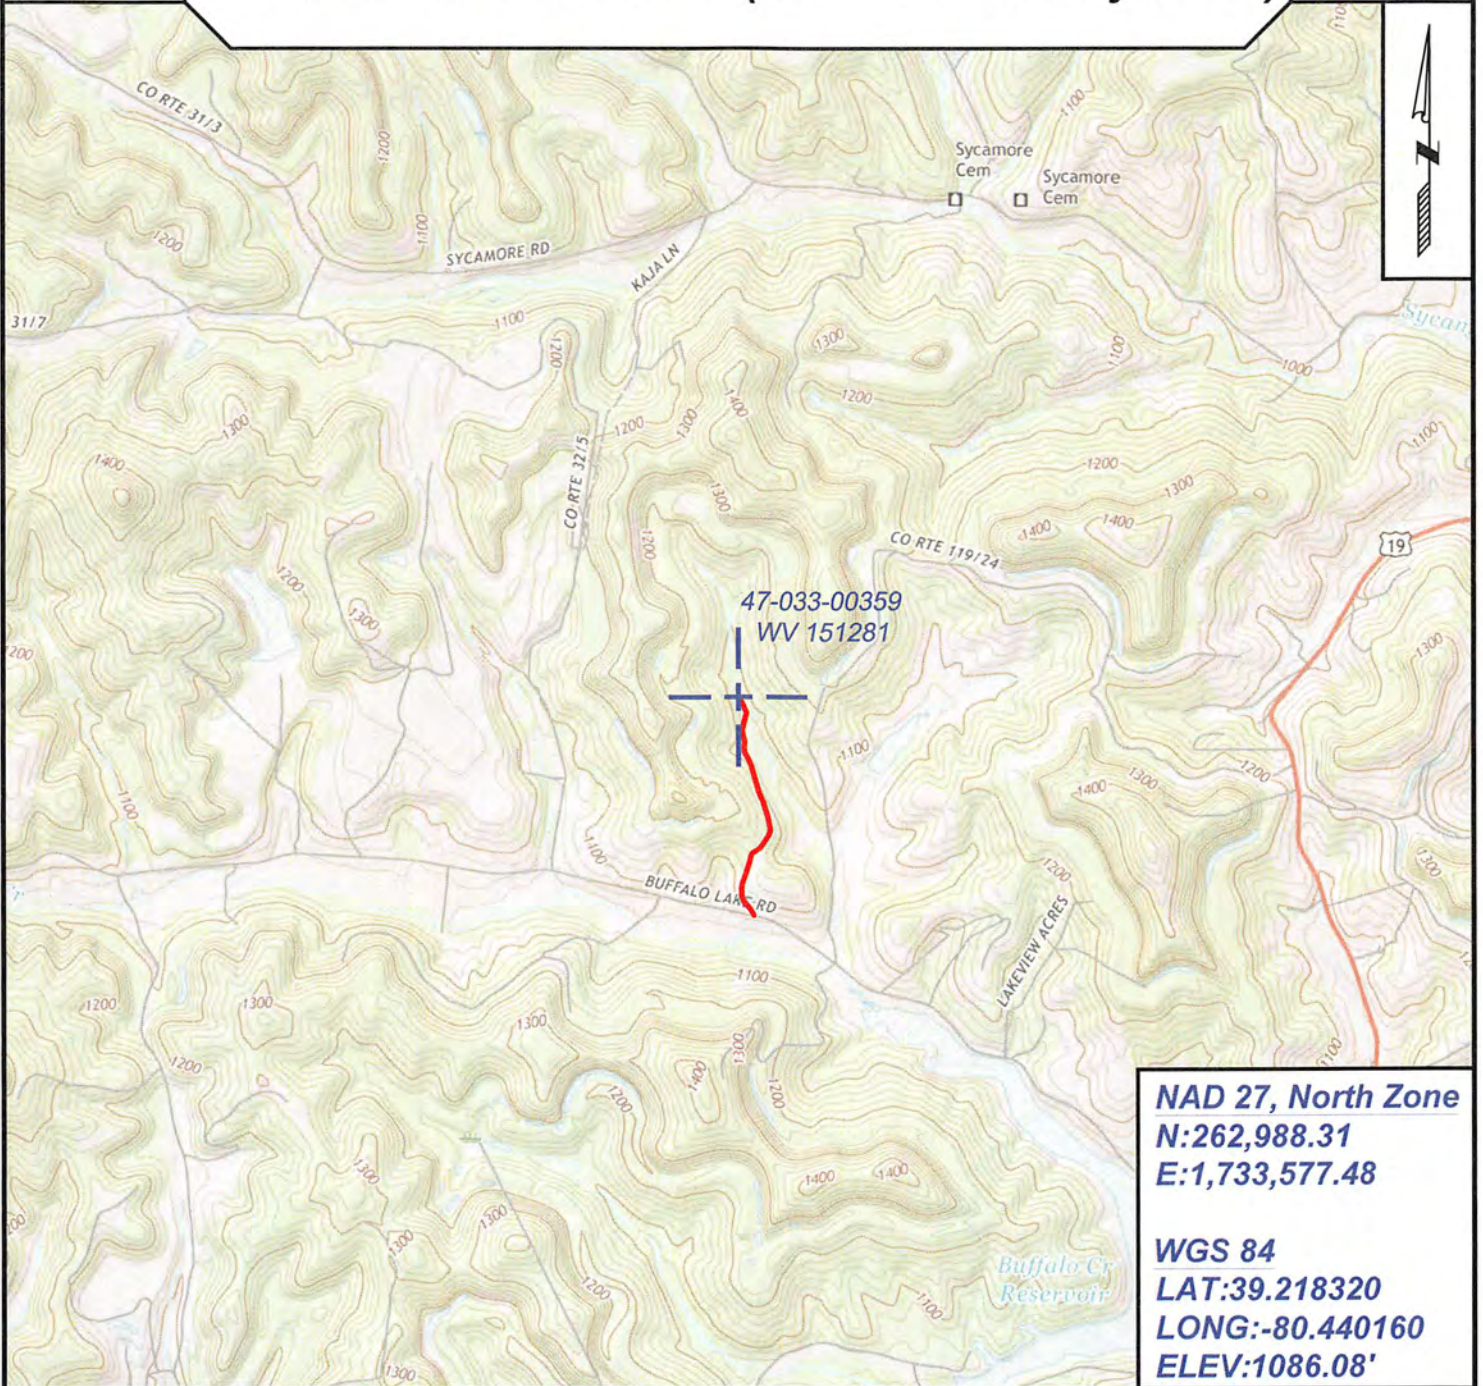

NAD 27, North Zone
N:262,988.31
E:1,733,577.48

WGS 84
LAT:39.218320
LONG:-80.440160
ELEV:1086.08'



SURVEYING AND MAPPING SERVICES PERFORMED BY:

ALLEGHENY SURVEYS, INC.

1-800-482-8606
 237 Birch River Road
 Birch River, WV 26610
 PH: (304) 649-8606
 FAX: (304) 649-8608

PREPARED FOR:

EQT Production Company

2400 Ansys Drive
 Canonsburg, PA 15317